






	1	2	3	4	5	6	7	8	9	10																																																																				
A			POWER SYSTEMS NETWORK MANAGEMENT PROTECTION AND SUBSTATION AUTOMATION SYSTEMS WBS NO: S-13656					ABB AUTOMATION COMPANY LTD. 414, AL-KHARJ ROAD SECOND INDUSTRIAL CITY RIYADH-11383 K.S.A																																																																						
B																																																																														
C	CONTRACTOR : ABB Contracting Company																																																																													
	CLIENT : National GridSA																																																																													
D	PROJECT : CONSTRUCTION OF NEW 132/13.8kV SS 8709 IN AL-KHARJ CITY																																																																													
	SUBSTATION : S/S 8709																																																																													
E	CONTRACT NO. : 11131113/00																																																																													
	TITLE : Assembly Drawing – +CBP2 [CAPACITOR BANK2]																																																																													
F																																																																														
G	<table><tr><td colspan="3">AS-BUILT BY _____ DATE _____</td><td colspan="2">CONTRACT NO. 11131113/00</td><td colspan="2">JOB ORDER NO. S-13656</td><td colspan="3">COVER SHEET</td><td colspan="2"> نقل الكهرباء الشركة الوطنية لنقل الكهرباء National Grid sa</td></tr><tr><td></td><td></td><td></td><td colspan="2">DRAWN BY <u>RIZ</u> CHECKED BY <u>KVR</u></td><td colspan="3">13.8kV CAPACITOR BANK-2 PROT. PANEL</td><td colspan="2">INDEX</td><td>PLANT NO.</td><td>DRAWING NUMBER</td><td>SHEET NO.</td><td>REV. NO.</td></tr><tr><td>01</td><td>14 08</td><td colspan="2">FACTORY AS BUILT</td><td colspan="2">DATE STARTED <u>24.01.2013</u> DATE COMPLETED _____</td><td colspan="3">S/S 8709-132/13.8KV IN AL-KHARJ CITY</td><td></td><td></td><td></td><td>SHT</td><td>CONT.</td></tr><tr><td>00</td><td>13 04</td><td colspan="2">FOR APPROVAL</td><td colspan="2">OPRG. DEPT. <u>CTPD</u> ENG. DEPT. <u>AUT-PSAC</u></td><td colspan="3">RIYADH SAUDI ARABIA</td><td>P</td><td>C421</td><td>CD-322953</td><td>G00</td><td>G01</td></tr><tr><td>REV. NO.</td><td>DATE</td><td colspan="2">DESCRIPTION</td><td colspan="2"></td><td colspan="3"></td><td></td><td></td><td></td><td></td><td></td></tr></table>										AS-BUILT BY _____ DATE _____			CONTRACT NO. 11131113/00		JOB ORDER NO. S-13656		COVER SHEET			 نقل الكهرباء الشركة الوطنية لنقل الكهرباء National Grid sa					DRAWN BY <u>RIZ</u> CHECKED BY <u>KVR</u>		13.8kV CAPACITOR BANK-2 PROT. PANEL			INDEX		PLANT NO.	DRAWING NUMBER	SHEET NO.	REV. NO.	01	14 08	FACTORY AS BUILT		DATE STARTED <u>24.01.2013</u> DATE COMPLETED _____		S/S 8709-132/13.8KV IN AL-KHARJ CITY						SHT	CONT.	00	13 04	FOR APPROVAL		OPRG. DEPT. <u>CTPD</u> ENG. DEPT. <u>AUT-PSAC</u>		RIYADH SAUDI ARABIA			P	C421	CD-322953	G00	G01	REV. NO.	DATE	DESCRIPTION											
AS-BUILT BY _____ DATE _____			CONTRACT NO. 11131113/00		JOB ORDER NO. S-13656		COVER SHEET			 نقل الكهرباء الشركة الوطنية لنقل الكهرباء National Grid sa																																																																				
			DRAWN BY <u>RIZ</u> CHECKED BY <u>KVR</u>		13.8kV CAPACITOR BANK-2 PROT. PANEL			INDEX		PLANT NO.	DRAWING NUMBER	SHEET NO.	REV. NO.																																																																	
01	14 08	FACTORY AS BUILT		DATE STARTED <u>24.01.2013</u> DATE COMPLETED _____		S/S 8709-132/13.8KV IN AL-KHARJ CITY						SHT	CONT.																																																																	
00	13 04	FOR APPROVAL		OPRG. DEPT. <u>CTPD</u> ENG. DEPT. <u>AUT-PSAC</u>		RIYADH SAUDI ARABIA			P	C421	CD-322953	G00	G01																																																																	
REV. NO.	DATE	DESCRIPTION																																																																												

THIS DRAWING AND THE INFORMATION CONTAINED HEREIN ARE THE SOLE PROPERTY OF National Grid SA NO REPRODUCTION IN FULL OR IN PART SHALL BE OBTAINED FROM THIS DOCUMENT WITHOUT THE WRITTEN CONSENT OF ITS OWNER.



PLANE – B			
SCH.REF	DESCRIPTION	TYPE	MAKE
1X1,2X1	CT CIRCUITS	OTTA 6T P/P	PHOENIX
1X2,2X2	VT CIRCUITS	D6/8.ST1.RS	PHOENIX
X3	AC INCOMING CIRCUITS	D6/8.ST1.RS	ENTRELEC
1X4,2X4	DC INCOMING CIRCUITS	D6/8.ST1.RS	ENTRELEC
1X5,2X5	CONTROL CIRCUITS	M6/8.RS	ENTRELEC
XTJ	TELEPHONE JACK	M6/8.RS	ENTRELEC
XSH	SPACE HEATER	M6/8.RS	ENTRELEC

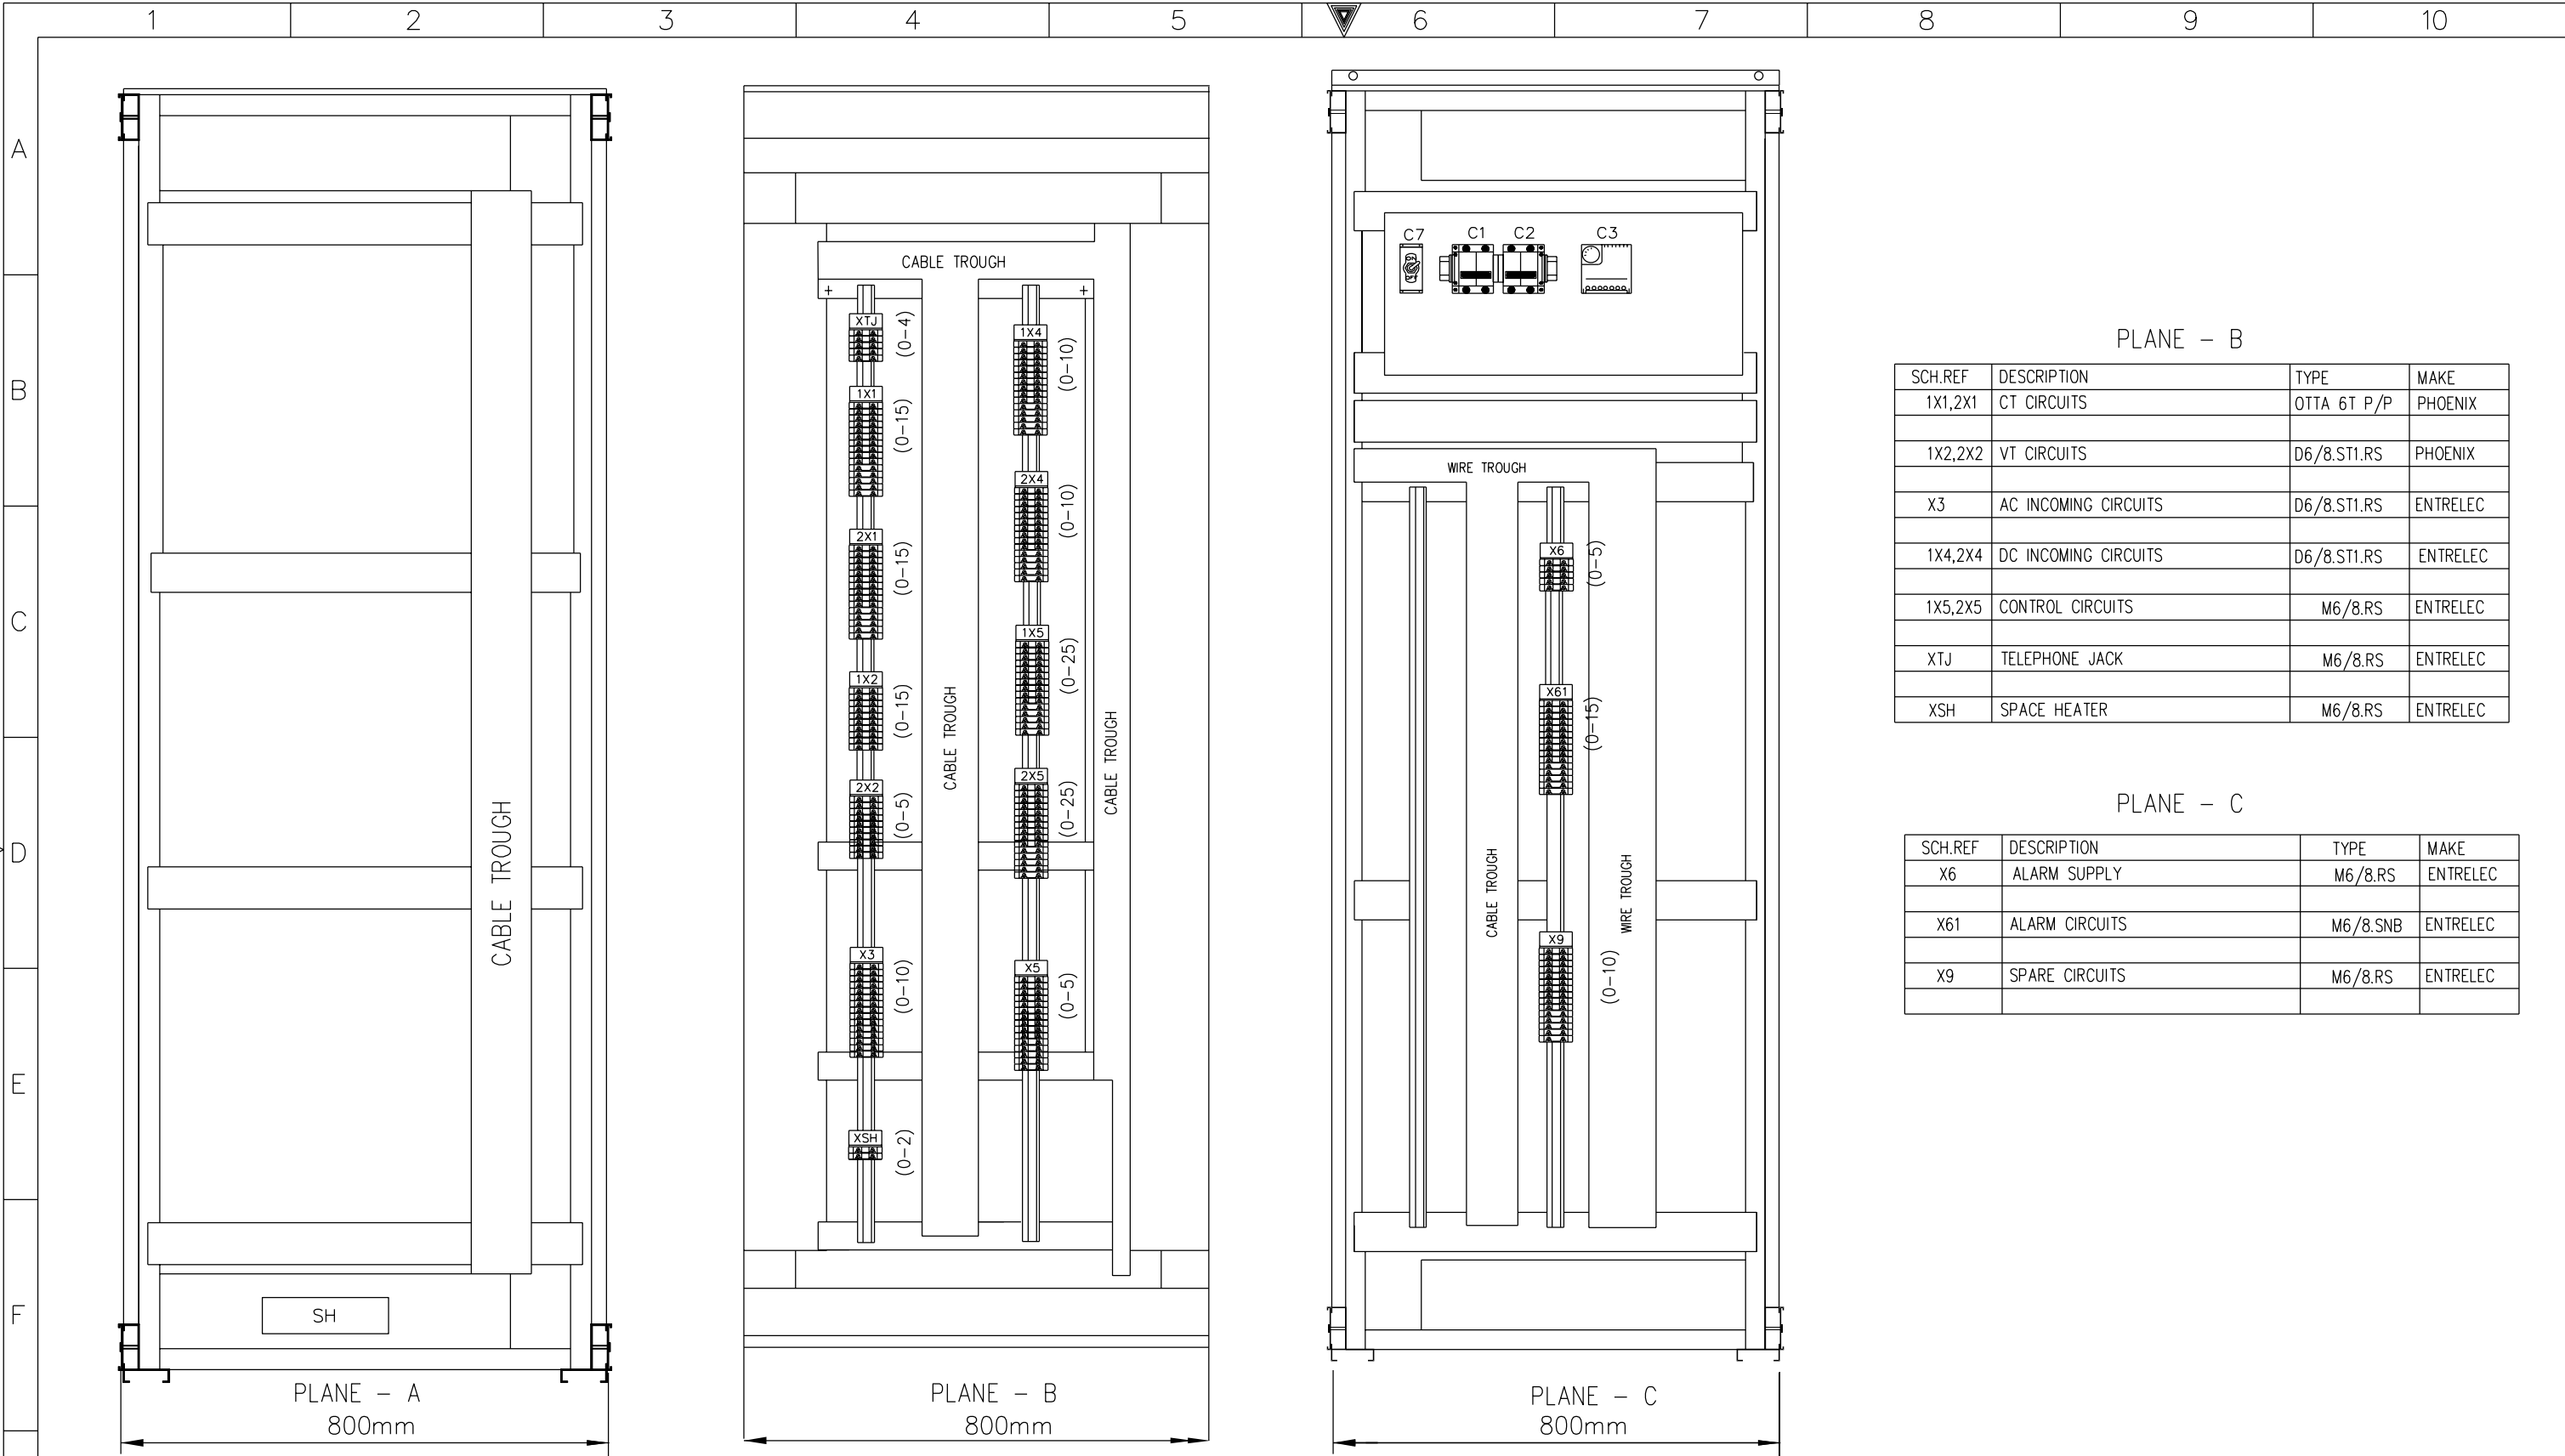PLANE – C			
SCH.REF	DESCRIPTION	TYPE	MAKE
X6	ALARM SUPPLY	M6/8.RS	ENTRELEC
X61	ALARM CIRCUITS	M6/8.SNB	ENTRELEC
X9	SPARE CIRCUITS	M6/8.RS	ENTRELEC

AS-BUILT BY _____ DATE _____

CONTRACT NO. 11131113/00

JOB ORDER NO. S-13656

0114 08FACTORY AS BUILT

0013 04FOR APPROVAL

REV. NO. DATE DESCRIPTION

DRAWN BY RIZ CHECKED BY KVR

DATE STARTED 24.01.2013 DATE COMPLETED _____

OPRG. DEPT. CTPD ENG. DEPT. AUT-PSAC


ASSEMBLY DRAWING

13.8kV CAPACITOR BANK-2 PROT. PANEL

S/S 8709-132/13.8KV IN AL-KHARJ CITY

RIYADH SAUDI ARABIA

الشركة الوطنية لنقل الكهرباء

 **نقل الكهرباء**
National Grid sa

INDEX

PLANT NO.

DRAWING NUMBER

SHEET NO.

SHTCONT.

REV. NO.



P

C421

CD-322953

G02G03

01

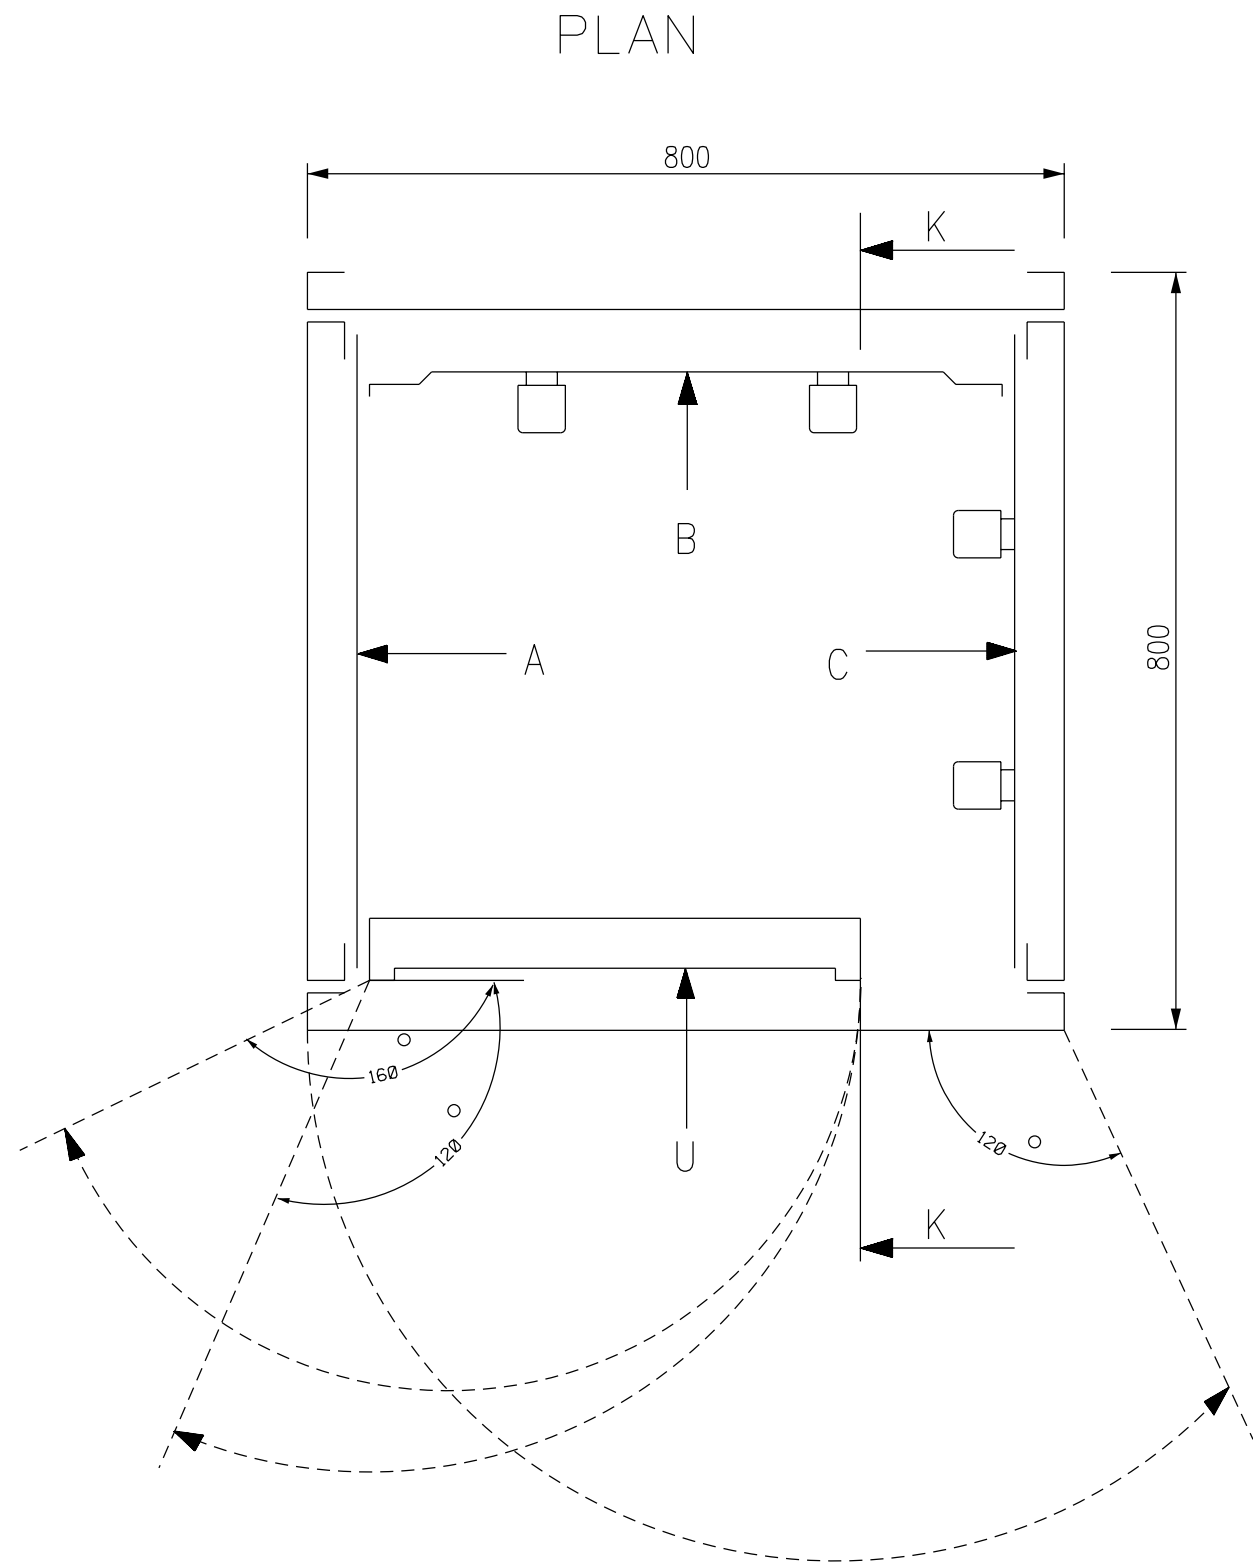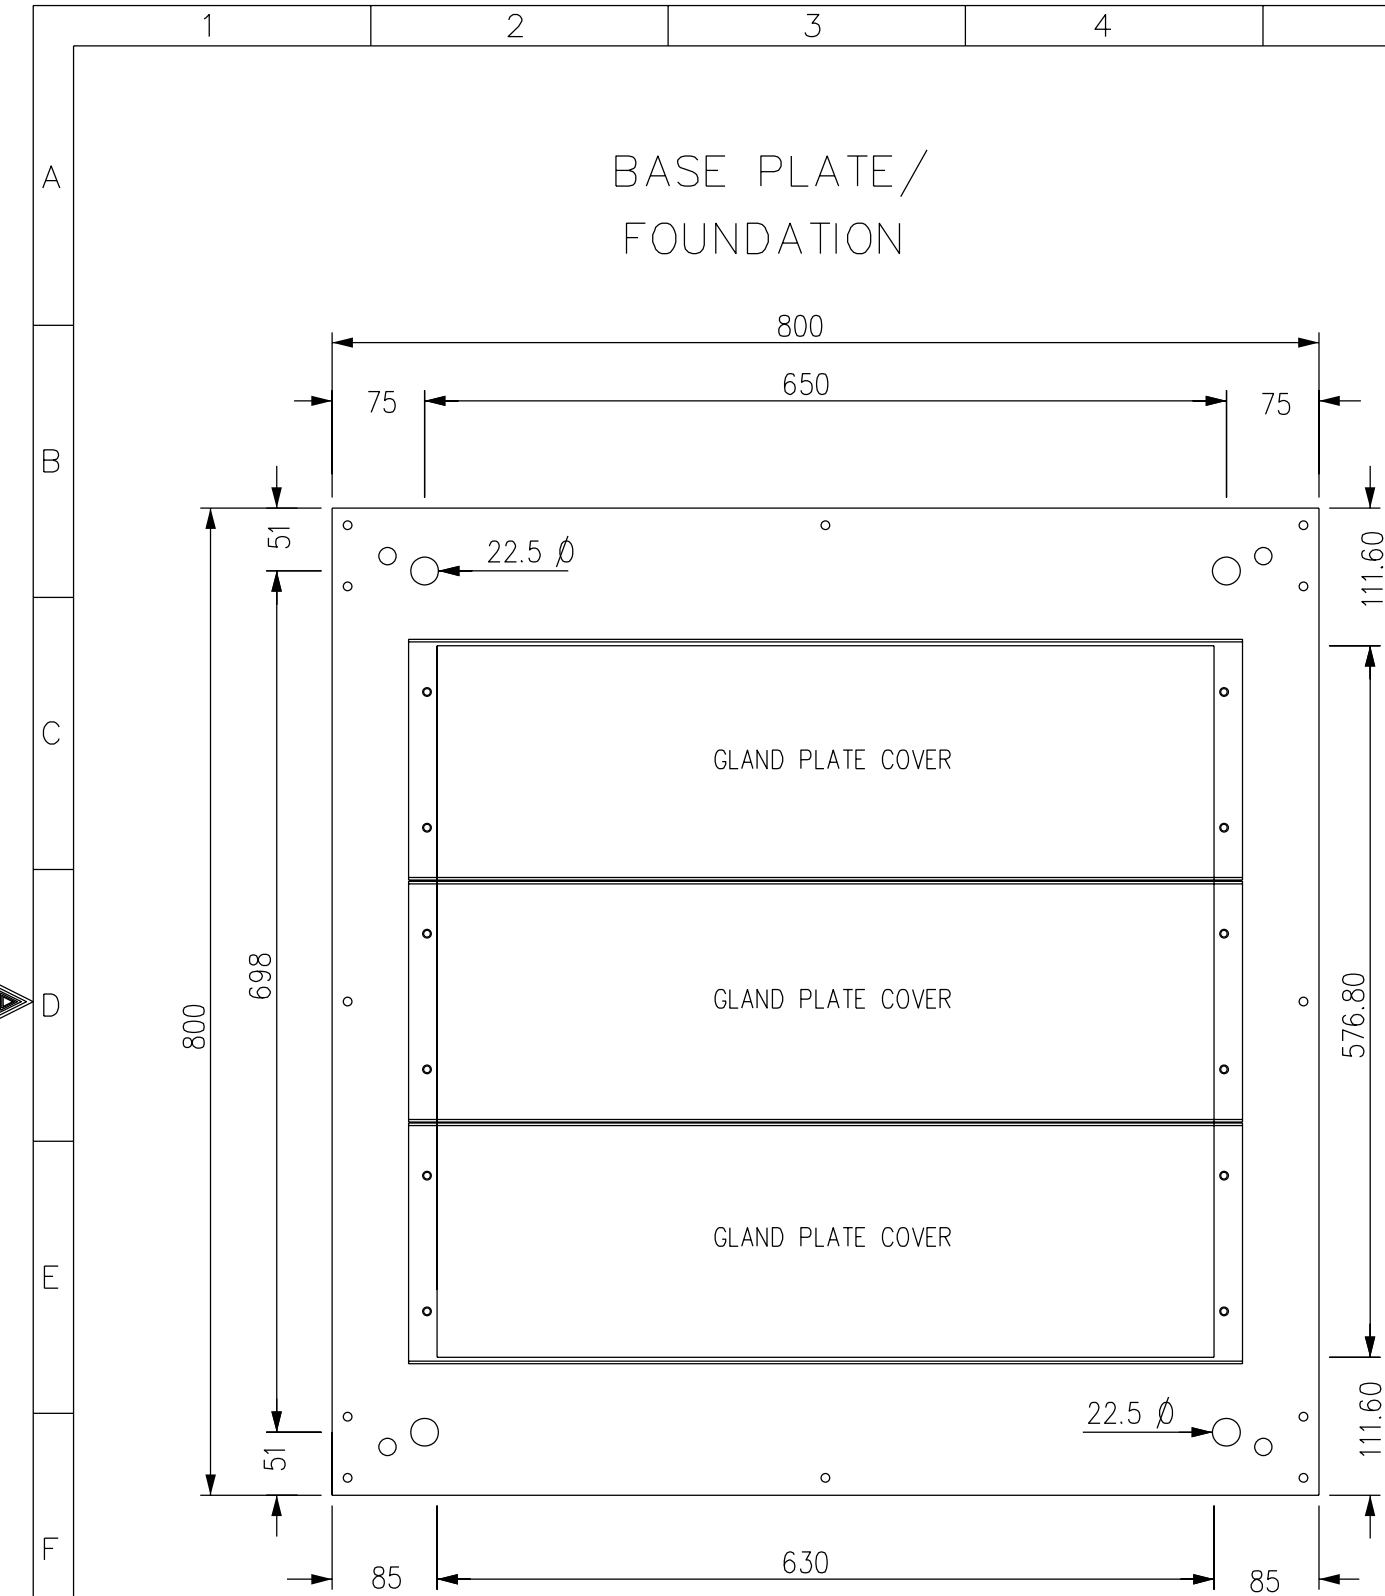




AS-BUILT BY _____ DATE _____ CONTRACT NO. 11131113/00 JOB ORDER NO. S-13656

01	14 08	FACTORY AS BUILT
00	13 04	FOR APPROVAL
REV. NO.	DATE	DESCRIPTION

DRAWN BY	RIZ	CHECKED BY	KVR
DATE STARTED	24.01.2013	DATE COMPLETED	
OPRG. DEPT.	CTPD	ENG. DEPT.	AUT-PSAC

ASSEMBLY DRAWING	
13.8kV CAPACITOR BANK-2 PROT. PANEL	
S/S 8709-132/13.8KV IN AL-KHARJ CITY	
RIYADH SAUDI ARABIA	

الشركة الوطنية لنقل الكهرباء		نقل الكهرباء	
National Grid sa		National Grid sa	
INDEX	PLANT NO.	DRAWING NUMBER	SHEET NO.
P	C421	CD-322953	SHT CONT.
		01	

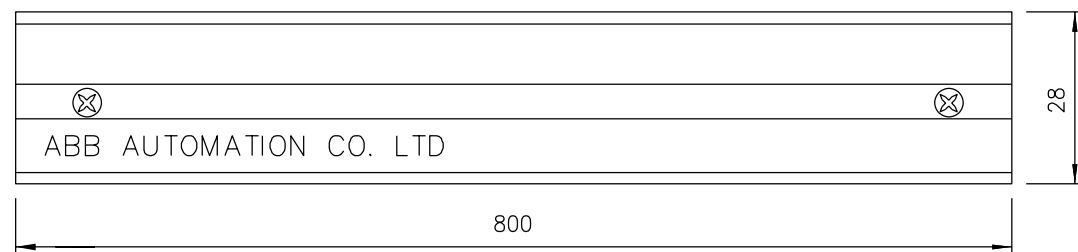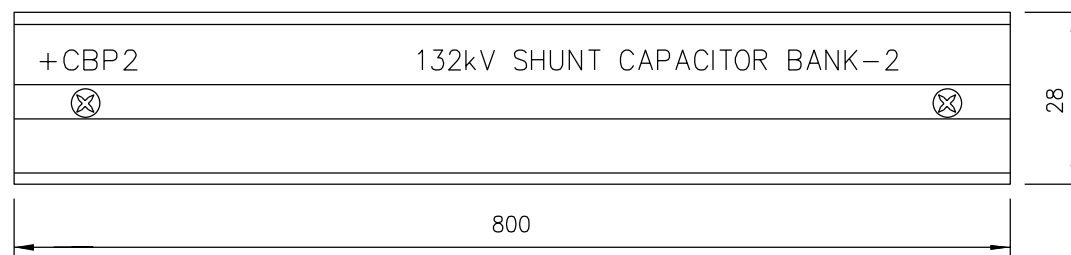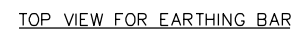

MANUFACTURING LABEL



PROJECT	:	National Grid SA S/S 8709
ORDER REFERENCE	:	2875 RF S13656
YEAR OF MANUFACTURE:	:	2013
PANEL NO.	:	+CBP2
DRAWING NO.	:	S13656-CD-323954

MADE IN THE KINGDOM OF SAUDI ARABIA

AS-BUILT BY _____ DATE _____	CONTRACT NO. 11131113/00	JOB ORDER NO. S-13656
------------------------------	--------------------------	-----------------------

			DRAWN BY <u>RIZ</u> CHECKED BY <u>KVR</u>
01	14 08	FACTORY AS BUILT	DATE STARTED <u>24.01.2013</u> DATE COMPLETED _____
00	13 04	FOR APPROVAL	
REV. NO.	DATE	DESCRIPTION	OPRG. DEPT. <u>CTPD</u> ENG. DEPT. <u>AUT-PSAC</u>

ASSEMBLY DRAWING

13.8kV CAPACITOR BANK-2 PROT. PANEL

S/S 8709-132/13.8KV IN AL-KHARJ CITY

RIYADH

SAUDI ARABIA

الشركة الوطنية لنقل الكهرباء







INDEX	PLANT NO.	DRAWING NUMBER	SHEET NO.		REV. NO.
P	C421	CD-322953	SHT	CONT.	01
			G04	00	

NG/D2-D (2012/01)

DMS

VECTOR

NGD200

	1	2	3	4	5	6	7	8	9	10																																																																																																																																				
A			POWER SYSTEMS NETWORK MANAGEMENT PROTECTION AND SUBSTATION AUTOMATION SYSTEMS WBS NO: S-13656					ABB AUTOMATION COMPANY LTD. 414, AL-KHARJ ROAD SECOND INDUSTRIAL CITY RIYADH-11383 K.S.A																																																																																																																																						
B																																																																																																																																														
C	CONTRACTOR : ABB Contracting Company																																																																																																																																													
	CLIENT : National Gridsa																																																																																																																																													
D	PROJECT : CONSTRUCTION OF NEW 132/13.8kV SS 8709 IN AL-KHARJ CITY																																																																																																																																													
	SUBSTATION : S/S 8709																																																																																																																																													
E	CONTRACT NO. : 11131113/00																																																																																																																																													
	TITLE : LIST OF APPARATUS – +CBP2 [SHUNT CAPACITOR BANK2]																																																																																																																																													
F																																																																																																																																														
G	<table><tr><td colspan="3">AS-BUILT BY _____ DATE _____</td><td colspan="2">CONTRACT NO. 11131113/00</td><td colspan="2">JOB ORDER NO. S-13656</td><td colspan="3">COVER SHEET</td><td colspan="2"> نقل الكهرباء الشركة الوطنية لنقل الكهرباء National Grid sa</td></tr><tr><td colspan="2">01</td><td colspan="1">14 08</td><td colspan="2">FACTORY AS BUILT</td><td colspan="2">DRAWN BY <u>RIZ</u> CHECKED BY <u>KVR</u></td><td colspan="3">13.8kV CAPACITOR BANK-2 PROT. PANEL</td><td colspan="2">INDEX</td></tr><tr><td colspan="2">00</td><td colspan="1">13 04</td><td colspan="2">FOR APPROVAL</td><td colspan="2">DATE STARTED <u>24.01.2013</u> DATE COMPLETED _____</td><td colspan="3">S/S 8709-132/13.8KV IN AL-KHARJ CITY</td><td colspan="2">PLANT NO.</td></tr><tr><td colspan="2">REV. NO.</td><td colspan="1">DATE</td><td colspan="2">DESCRIPTION</td><td colspan="2">OPRG. DEPT. <u>CTPD</u> ENG. DEPT. <u>AUT-PSAC</u></td><td colspan="3">RIYADH SAUDI ARABIA</td><td colspan="2">DRAWING NUMBER</td></tr><tr><td colspan="2"></td><td colspan="1"></td><td colspan="2"></td><td colspan="2"></td><td colspan="3"></td><td colspan="2">SHEET NO.</td></tr><tr><td colspan="2"></td><td colspan="1"></td><td colspan="2"></td><td colspan="2"></td><td colspan="3"></td><td colspan="2">REV. NO.</td></tr><tr><td colspan="2"></td><td colspan="1"></td><td colspan="2"></td><td colspan="2"></td><td colspan="3"></td><td colspan="2">SHT</td></tr><tr><td colspan="2"></td><td colspan="1"></td><td colspan="2"></td><td colspan="2"></td><td colspan="3"></td><td colspan="2">CONT.</td></tr><tr><td colspan="2"></td><td colspan="1"></td><td colspan="2"></td><td colspan="2"></td><td colspan="3"></td><td colspan="2">01</td></tr><tr><td colspan="2"></td><td colspan="1"></td><td colspan="2"></td><td colspan="2"></td><td colspan="3"></td><td colspan="2">L00</td></tr><tr><td colspan="2"></td><td colspan="1"></td><td colspan="2"></td><td colspan="2"></td><td colspan="3"></td><td colspan="2">L01</td></tr></table>										AS-BUILT BY _____ DATE _____			CONTRACT NO. 11131113/00		JOB ORDER NO. S-13656		COVER SHEET			 نقل الكهرباء الشركة الوطنية لنقل الكهرباء National Grid sa		01		14 08	FACTORY AS BUILT		DRAWN BY <u>RIZ</u> CHECKED BY <u>KVR</u>		13.8kV CAPACITOR BANK-2 PROT. PANEL			INDEX		00		13 04	FOR APPROVAL		DATE STARTED <u>24.01.2013</u> DATE COMPLETED _____		S/S 8709-132/13.8KV IN AL-KHARJ CITY			PLANT NO.		REV. NO.		DATE	DESCRIPTION		OPRG. DEPT. <u>CTPD</u> ENG. DEPT. <u>AUT-PSAC</u>		RIYADH SAUDI ARABIA			DRAWING NUMBER												SHEET NO.												REV. NO.												SHT												CONT.												01												L00												L01	
AS-BUILT BY _____ DATE _____			CONTRACT NO. 11131113/00		JOB ORDER NO. S-13656		COVER SHEET			 نقل الكهرباء الشركة الوطنية لنقل الكهرباء National Grid sa																																																																																																																																				
01		14 08	FACTORY AS BUILT		DRAWN BY <u>RIZ</u> CHECKED BY <u>KVR</u>		13.8kV CAPACITOR BANK-2 PROT. PANEL			INDEX																																																																																																																																				
00		13 04	FOR APPROVAL		DATE STARTED <u>24.01.2013</u> DATE COMPLETED _____		S/S 8709-132/13.8KV IN AL-KHARJ CITY			PLANT NO.																																																																																																																																				
REV. NO.		DATE	DESCRIPTION		OPRG. DEPT. <u>CTPD</u> ENG. DEPT. <u>AUT-PSAC</u>		RIYADH SAUDI ARABIA			DRAWING NUMBER																																																																																																																																				
										SHEET NO.																																																																																																																																				
										REV. NO.																																																																																																																																				
										SHT																																																																																																																																				
										CONT.																																																																																																																																				
										01																																																																																																																																				
										L00																																																																																																																																				
										L01																																																																																																																																				

	1	2	3	4	5	6	7	8	9	10
A										
B										
C										
D										
E										
	F									
G										

AS-BUILT BY _____ DATE _____

CONTRACT NO. 11131113/00

JOB ORDER NO. S-13656

01

14 08

FACTORY AS BUILT

00

13 04

FOR APPROVAL

REV. NO.

DATE

DESCRIPTION

DRAWN BY RIZ

CHECKED BY KVR

DATE STARTED 24.01.2013

DATE COMPLETED _____

OPRG. DEPT. CTPD

ENG. DEPT. AUT-PSAC


LIST OF APPARATUS

13.8kV CAPACITOR BANK-2 PROT. PANEL

S/S 8709-132/13.8KV IN AL-KHARJ CITY

RIYADH SAUDI ARABIA

الشركة الوطنية لنقل الكهرباء



National Grid sa

INDEX

PLANT NO.

DRAWING NUMBER

SHEET NO.

REV. NO.

P

C421

CD-322953

L01

L02

01

NG/D2-D (2012/01)

DMS

VECTOR

NGD200

THIS DRAWING AND THE INFORMATION CONTAINED HEREIN ARE THE SOLE PROPERTY OF National Grid SA NO REPRODUCTION IN FULL OR IN PART SHALL BE OBTAINED FROM THIS DOCUMENT WITHOUT THE WRITTEN CONSENT OF ITS OWNER.

	1	2	3	4	5	6	7	8	9	10						
A																
B	SR. NO.	LOCATION REF.	SCH REF.	D E S C R I P T I O N		SHT NO.	QTY.	TYPE	MAKE	ORDERING INFORMATION						
	3	U17.5001	TS-1	TEST SWITCH FOR GROUP-1 PROTECTION		213	1	RXTP24	ABB	RK 926 315-AG						
	4	U17.5002	TS-2	TEST SWITCH FOR GROUP-2 PROTECTION		214	1	RXTP24	ABB	RK 926 315-AK						
	5	U23.5001	86C-1	GROUP-1 LOCKOUT RELAY		218	1	MVAJ105	ALSTOM	MVAJ105RA0802A						
C				AUX. VOLTAGE : 125V DC												
				CONTACTS : 8NO + 2NC												
				FLAG:STANDARD HAND RESET												
				CONTACT MECHANISM:HAND & ELECTRICAL RESET												
D	6	U23.5002	94-1	TRIP RELAY		218	1	MVAJ101	ALSTOM	MVAJ101RA0800A						
				AUX. VOLTAGE : 125V DC												
				CONTACTS : 10NO												
E	7	U23.5003	86BF	BF LOCKOUT RELAY		220	1	MVAJ105	ALSTOM	MVAJ105RA0802A						
				AUX. VOLTAGE : 125V DC/TRIPPING RELAY-HIGH BURDEN												
				CONTACTS : 8NO + 2NC												
				FLAG:STANDARD HAND RESET												
F				CONTACT MECHANISM:HAND & ELECTRICAL RESET												
	8	U23.5004	86C-2	GROUP-2 LOCKOUT RELAY		220	1	MVAJ105	ALSTOM	MVAJ105RA0802A						
				AUX. VOLTAGE : 125V DC												
				CONTACTS : 8NO + 2NC												
G				FLAG:STANDARD HAND RESET												
				CONTACT MECHANISM:HAND & ELECTRICAL RESET												
	9	U23.5005	94-2	TRIP RELAY		220	1	MVAJ101	ALSTOM	MVAJ101RA0800A						
				AUX. VOLTAGE : 125V DC												
H				CONTACTS : 10NO												
	10	U21.5001	PB11	PUSH BUTTON FOR RESETTING 86C-1 LOCKOUT RELAY		218	1	MP1-10B	ABB	1SFA 611 100 R1006						
				BUTTON COLOUR ;BLACK:CONTACT DATA:1NO+1NC				MCBH-20		1SFA 611 605 R1102						
I	11	U21.5002	PB22	PUSH BUTTON FOR RESETTING 86BF LOCKOUT RELAY		220	1	MP1-10B	ABB	1SFA 611 100 R1006						
				BUTTON COLOUR ;BLACK:CONTACT DATA:1NO+1NC				MCBH-20		1SFA 611 605 R1102						
	12	U21.5003	PB21	PUSH BUTTON FOR RESETTING 86C-2 LOCKOUT RELAY		220	1	MP1-10B	ABB	1SFA 611 100 R1006						
				BUTTON COLOUR ;BLACK:CONTACT DATA:1NO+1NC			1	MCBH-20		1SFA 611 605 R1102						
J																
	13	U27.301	74R1	DC SUPERVISION RELAY (REVERSE FLAG)		218		RXSF1	ABB	RK 271 019-AN						
			SPARE	AUX. VOLTAGE : 110-125V DC												
				CONTACTS : 1NO + 2NC PER COIL												
K				FLAG : SELF RESET												
L	AS-BUILT BY _____ DATE _____		CONTRACT NO. 11131113/00		JOB ORDER NO. S-13656		LIST OF APPARATUS		الشركة الوطنية لنقل الكهرباء National Grid sa							
	01	14 08	FACTORY AS BUILT		DRAWN BY RIZ CHECKED BY KVR		13.8kV CAPACITOR BANK-2 PROT. PANEL									
	00	13 04	FOR APPROVAL		DATE STARTED 24.01.2013 DATE COMPLETED _____		S/S 8709-132/13.8KV IN AL-KHARJ CITY									
	REV. NO.	DATE	DESCRIPTION		OPRG. DEPT. CTPD ENG. DEPT. AUT-PSAC		RIYADH SAUDI ARABIA									
								INDEX		PLANT NO.	DRAWING NUMBER		SHEET NO.		REV. NO.	
								P		C421	CD-322953		SHT L02		CONT. L03	
															01	



DMS

VECTOR

NGD200

NG/D2-D (2012/01)

	1	2	3	4	5	6	7	8	9	10				
A		SR. NO.	LOCATION REF.	SCH. REF.	D E S C R I P T I O N		SHT NO.	QTY.	TYPE	MAKE	ORDERING INFORMATION			
		24		1X1	BOLT CONNECTING TERMINAL BLOCK DISCONNECTABLE FOR CT CIRCUIT		605	15	OTTA6T-P/P	PHOENIX	0790462			
				2X1			605	15						
		25		1X2	SPRING LOADED TERMINAL BLOCK DISCONNECTABLE FOR PT SUPPLY		605	10	D6/8.ST1.RS	ENTRELEC	1SNA 115 831 R0400			
				2X2			605	5						
B		26		X3	SPRING LOADED TERMINAL BLOCKS FOR AC SUPPLY		605	10	D6/8.ST1.RS	ENTRELEC	1SNA 115 831 R0400			
		27		1X4	SPRING LOADED TERMINAL BLOCK FOR DC CIRCUIT		605	10	D6/8.ST1.RS	ENTRELEC	1SNA 115 831 R0400			
				2X4			605	10						
		28		1X5	SPRING LOADED TERMINAL BLOCK FOR CONTROL CIRCUIT		605	25	M6/8.RS	ENTRELEC	1SNA 115 685 R1200			
				2X5			605	25						
		29		X5	SPRING LOADED TERMINAL BLOCK FOR CONTROL CIRCUIT		605	5	M6/8.RS	ENTRELEC	1SNA 115 685 R1200			
		30		X61	SRING LOADED TERMINAL BLOCK FOR STN.-COM ALARM PANEL		604	10	M6/8 SNB	ENTRELEC	1SNA 115 688 R2500			
C		31		XSH	SPRING LOADED TERMINAL BLOCK FOR SPACE HEATER		605	2	M6/8.RS	ENTRELEC	1SNA 115 688 R2500			
		32		XTJ	SPRING LOADED TERMINAL BLOCK FOR TELEPHONE JACK		605	4	M6/8.RS	ENTRELEC	ISNA 115 685 R1200			
		33		X9	SPRING LOADED TERMINAL BLOCK FOR SPARE CONTACT		605	10	M6/8.RS	ENTRELEC	ISNA 115 685 R1200			
D		34		X6	SPRING LOADED TERMINAL FOR ALARM		605	5	M6/8.RS	ENTRELEC	1SNA 115 688 R2500			
E														
F														
G		AS-BUILT BY _____ DATE _____		CONTRACT NO. 11131113/00		JOB ORDER NO. S-13656		LIST OF APPARATUS		<div>الشركة الوطنية لنقل الكهرباء</div> <div>نقل الكهرباء</div> <div>National Grid sa</div>				
				DRAWN BY <u>RIZ</u> CHECKED BY <u>KVR</u>		13.8kV CAPACITOR BANK-2 PROT. PANEL								
		01	14 08	FACTORY AS BUILT		DATE STARTED <u>24.01.2013</u> DATE COMPLETED _____		S/S 8709-132/13.8KV IN AL-KHARJ CITY		INDEX	PLANT NO.	DRAWING NUMBER	SHEET NO.	REV. NO.
		00	13 04	FOR APPROVAL		OPRG. DEPT. <u>CTPD</u> ENG. DEPT. <u>AUT-PSAC</u>		RIYADH SAUDI ARABIA		P	C421	CD-322953	SHT <u>L04</u> CONT. <u>L05</u>	01





THIS DRAWING AND THE INFORMATION CONTAINED HEREIN ARE THE SOLE PROPERTY OF National Grid SA NO REPRODUCTION IN FULL OR IN PART SHALL BE OBTAINED FROM THIS DOCUMENT WITHOUT THE WRITTEN CONSENT OF ITS OWNER.

	1	2	3	4	5	6	7	8	9	10																																																																
A																																																																										
B																																																																										
C																																																																										
D																																																																										
E																																																																										
F																																																																										
G	<table><tr><td colspan="3">AS-BUILT BY _____ DATE _____</td><td colspan="2">CONTRACT NO. 11131113/00</td><td colspan="2">JOB ORDER NO. S-13656</td><td colspan="3">LIST OF APPARATUS</td><td colspan="2"><div>الشركة الوطنية لنقل الكهرباء</div><div>نقل الكهرباء</div><div>National Grid sa</div></td></tr><tr><td></td><td></td><td></td><td colspan="2">DRAWN BY <u>RIZ</u> CHECKED BY <u>KVR</u></td><td colspan="3">13.8kV CAPACITOR BANK-2 PROT. PANEL</td><td>INDEX</td><td>PLANT NO.</td><td>DRAWING NUMBER</td><td>SHEET NO.</td><td>REV. NO.</td></tr><tr><td></td><td>01</td><td>14 08</td><td colspan="2">FACTORY AS BUILT</td><td colspan="3">S/S 8709-132/13.8KV IN AL-KHARJ CITY</td><td></td><td></td><td></td><td>SHT</td><td>CONT.</td></tr><tr><td></td><td>00</td><td>13 04</td><td colspan="2">FOR APPROVAL</td><td colspan="3">RIYADH SAUDI ARABIA</td><td>P</td><td>C421</td><td>CD-322953</td><td>L05</td><td>L06</td></tr><tr><td></td><td>REV. NO.</td><td>DATE</td><td colspan="2">DESCRIPTION</td><td colspan="2">OPRG. DEPT. <u>CTPD</u> ENG. DEPT. <u>AUT-PSAC</u></td><td colspan="6"></td></tr></table>										AS-BUILT BY _____ DATE _____			CONTRACT NO. 11131113/00		JOB ORDER NO. S-13656		LIST OF APPARATUS			<div>الشركة الوطنية لنقل الكهرباء</div> <div>نقل الكهرباء</div> <div>National Grid sa</div>					DRAWN BY <u>RIZ</u> CHECKED BY <u>KVR</u>		13.8kV CAPACITOR BANK-2 PROT. PANEL			INDEX	PLANT NO.	DRAWING NUMBER	SHEET NO.	REV. NO.		01	14 08	FACTORY AS BUILT		S/S 8709-132/13.8KV IN AL-KHARJ CITY						SHT	CONT.		00	13 04	FOR APPROVAL		RIYADH SAUDI ARABIA			P	C421	CD-322953	L05	L06		REV. NO.	DATE	DESCRIPTION		OPRG. DEPT. <u>CTPD</u> ENG. DEPT. <u>AUT-PSAC</u>							
AS-BUILT BY _____ DATE _____			CONTRACT NO. 11131113/00		JOB ORDER NO. S-13656		LIST OF APPARATUS			<div>الشركة الوطنية لنقل الكهرباء</div> <div>نقل الكهرباء</div> <div>National Grid sa</div>																																																																
			DRAWN BY <u>RIZ</u> CHECKED BY <u>KVR</u>		13.8kV CAPACITOR BANK-2 PROT. PANEL			INDEX	PLANT NO.	DRAWING NUMBER	SHEET NO.	REV. NO.																																																														
	01	14 08	FACTORY AS BUILT		S/S 8709-132/13.8KV IN AL-KHARJ CITY						SHT	CONT.																																																														
	00	13 04	FOR APPROVAL		RIYADH SAUDI ARABIA			P	C421	CD-322953	L05	L06																																																														
	REV. NO.	DATE	DESCRIPTION		OPRG. DEPT. <u>CTPD</u> ENG. DEPT. <u>AUT-PSAC</u>																																																																					

THIS DRAWING AND THE INFORMATION CONTAINED HEREIN ARE THE SOLE PROPERTY OF National Grid SA NO REPRODUCTION IN FULL OR IN PART SHALL BE OBTAINED FROM THIS DOCUMENT WITHOUT THE WRITTEN CONSENT OF ITS OWNER.

	1	2	3	4	5	6	7	8	9	10																																																																
A																																																																										
B																																																																										
C																																																																										
D																																																																										
E																																																																										
F																																																																										
G	<table><tr><td colspan="3">AS-BUILT BY _____ DATE _____</td><td colspan="2">CONTRACT NO. 11131113/00</td><td colspan="2">JOB ORDER NO. S-13656</td><td colspan="3">LIST OF APPARATUS</td><td colspan="2"><div>الشركة الوطنية لنقل الكهرباء</div><div>نقل الكهرباء</div><div>National Grid sa</div></td></tr><tr><td></td><td></td><td></td><td colspan="2">DRAWN BY <u>RIZ</u> CHECKED BY <u>KVR</u></td><td colspan="3">13.8kv CAPACITOR BANK-2 PROT. PANEL</td><td>INDEX</td><td>PLANT NO.</td><td>DRAWING NUMBER</td><td>SHEET NO.</td><td>REV. NO.</td></tr><tr><td></td><td>01</td><td>14 08</td><td colspan="2">FACTORY AS BUILT</td><td colspan="3">S/S 8709-132/13.8KV IN AL-KHARJ CITY</td><td></td><td></td><td></td><td>SHT</td><td>CONT.</td></tr><tr><td></td><td>00</td><td>13 04</td><td colspan="2">FOR APPROVAL</td><td colspan="3">RIYADH SAUDI ARABIA</td><td>P</td><td>C421</td><td>CD-322953</td><td>L06</td><td>NIL</td></tr><tr><td></td><td>REV. NO.</td><td>DATE</td><td colspan="2">DESCRIPTION</td><td colspan="2">OPRG. DEPT. <u>CTPD</u> ENG. DEPT. <u>AUT-PSAC</u></td><td colspan="6"></td></tr></table>										AS-BUILT BY _____ DATE _____			CONTRACT NO. 11131113/00		JOB ORDER NO. S-13656		LIST OF APPARATUS			<div>الشركة الوطنية لنقل الكهرباء</div> <div>نقل الكهرباء</div> <div>National Grid sa</div>					DRAWN BY <u>RIZ</u> CHECKED BY <u>KVR</u>		13.8kv CAPACITOR BANK-2 PROT. PANEL			INDEX	PLANT NO.	DRAWING NUMBER	SHEET NO.	REV. NO.		01	14 08	FACTORY AS BUILT		S/S 8709-132/13.8KV IN AL-KHARJ CITY						SHT	CONT.		00	13 04	FOR APPROVAL		RIYADH SAUDI ARABIA			P	C421	CD-322953	L06	NIL		REV. NO.	DATE	DESCRIPTION		OPRG. DEPT. <u>CTPD</u> ENG. DEPT. <u>AUT-PSAC</u>							
AS-BUILT BY _____ DATE _____			CONTRACT NO. 11131113/00		JOB ORDER NO. S-13656		LIST OF APPARATUS			<div>الشركة الوطنية لنقل الكهرباء</div> <div>نقل الكهرباء</div> <div>National Grid sa</div>																																																																
			DRAWN BY <u>RIZ</u> CHECKED BY <u>KVR</u>		13.8kv CAPACITOR BANK-2 PROT. PANEL			INDEX	PLANT NO.	DRAWING NUMBER	SHEET NO.	REV. NO.																																																														
	01	14 08	FACTORY AS BUILT		S/S 8709-132/13.8KV IN AL-KHARJ CITY						SHT	CONT.																																																														
	00	13 04	FOR APPROVAL		RIYADH SAUDI ARABIA			P	C421	CD-322953	L06	NIL																																																														
	REV. NO.	DATE	DESCRIPTION		OPRG. DEPT. <u>CTPD</u> ENG. DEPT. <u>AUT-PSAC</u>																																																																					

THIS DRAWING AND THE INFORMATION CONTAINED HEREIN ARE THE SOLE PROPERTY OF National Grid SA NO REPRODUCTION IN FULL OR IN PART SHALL BE OBTAINED FROM THIS DOCUMENT WITHOUT THE WRITTEN CONSENT OF ITS OWNER.

	1	2	3	4	5	6	7	8	9	10																																																						
A			POWER SYSTEMS NETWORK MANAGEMENT PROTECTION AND SUBSTATION AUTOMATION SYSTEMS WBS NO: S-13656					ABB AUTOMATION COMPANY LTD. 414, AL-KHARJ ROAD SECOND INDUSTRIAL CITY RIYADH-11383 K.S.A																																																								
B																																																																
C																																																																
D	CONTRACTOR : ABB Contracting Company																																																															
	CLIENT : National Gridsa																																																															
	PROJECT : CONSTRUCTION OF NEW 132/13.8kV SS 8709 IN AL-KHARJ CITY																																																															
	SUBSTATION : S/S 8709																																																															
E	CONTRACT NO. : 11131113/00																																																															
	TITLE : SCHEMATICS DRAWINGS +CBP2 (SHUNT CAPACITOR BANK-2)																																																															
F																																																																
G	<table><tr><td colspan="3">AS-BUILT BY _____ DATE _____</td><td colspan="2">CONTRACT NO. 11131113/00</td><td colspan="2">JOB ORDER NO. S-13656</td><td colspan="3">COVER SHEET</td><td colspan="2"> نقل الكهرباء الشركة الوطنية لنقل الكهرباء National Grid sa</td></tr><tr><td>01</td><td>14 08</td><td rowspan="2">FACTORY AS BUILT FOR APPROVAL</td><td colspan="3">DRAWN BY <u>RIZ</u> CHECKED BY <u>KVR</u></td><td colspan="3">13.8kV CAPACITOR BANK-2 PROT. PANEL</td><td>INDEX</td><td>PLANT NO.</td><td>DRAWING NUMBER</td><td>SHEET NO.</td><td>REV. NO.</td></tr><tr><td>00</td><td>13 04</td><td colspan="3">DATE STARTED <u>24.01.2013</u> DATE COMPLETED _____</td><td colspan="3">S/S 8709-132/13.8KV IN AL-KHARJ CITY</td><td>P</td><td>C421</td><td>CD-322954</td><td>SHT 000</td><td>CONT. 001</td><td>01</td></tr><tr><td>REV. NO.</td><td>DATE</td><td>DESCRIPTION</td><td colspan="3">OPRG. DEPT. <u>CTPD</u> ENG. DEPT. <u>AUT-PSAC</u></td><td colspan="3">RIYADH SAUDI ARABIA</td><td colspan="5"></td></tr></table>										AS-BUILT BY _____ DATE _____			CONTRACT NO. 11131113/00		JOB ORDER NO. S-13656		COVER SHEET			 نقل الكهرباء الشركة الوطنية لنقل الكهرباء National Grid sa		01	14 08	FACTORY AS BUILT FOR APPROVAL	DRAWN BY <u>RIZ</u> CHECKED BY <u>KVR</u>			13.8kV CAPACITOR BANK-2 PROT. PANEL			INDEX	PLANT NO.	DRAWING NUMBER	SHEET NO.	REV. NO.	00	13 04	DATE STARTED <u>24.01.2013</u> DATE COMPLETED _____			S/S 8709-132/13.8KV IN AL-KHARJ CITY			P	C421	CD-322954	SHT 000	CONT. 001	01	REV. NO.	DATE	DESCRIPTION	OPRG. DEPT. <u>CTPD</u> ENG. DEPT. <u>AUT-PSAC</u>			RIYADH SAUDI ARABIA							
AS-BUILT BY _____ DATE _____			CONTRACT NO. 11131113/00		JOB ORDER NO. S-13656		COVER SHEET			 نقل الكهرباء الشركة الوطنية لنقل الكهرباء National Grid sa																																																						
01	14 08	FACTORY AS BUILT FOR APPROVAL	DRAWN BY <u>RIZ</u> CHECKED BY <u>KVR</u>			13.8kV CAPACITOR BANK-2 PROT. PANEL			INDEX	PLANT NO.	DRAWING NUMBER	SHEET NO.	REV. NO.																																																			
00	13 04		DATE STARTED <u>24.01.2013</u> DATE COMPLETED _____			S/S 8709-132/13.8KV IN AL-KHARJ CITY			P	C421	CD-322954	SHT 000	CONT. 001	01																																																		
REV. NO.	DATE	DESCRIPTION	OPRG. DEPT. <u>CTPD</u> ENG. DEPT. <u>AUT-PSAC</u>			RIYADH SAUDI ARABIA																																																										

NG/D2-D (2012/01)

DMS

VECTOR

NGD200

THIS DRAWING AND THE INFORMATION CONTAINED HEREIN ARE THE SOLE PROPERTY OF National Grid SA NO REPRODUCTION IN FULL OR IN PART SHALL BE OBTAINED FROM THIS DOCUMENT WITHOUT THE WRITTEN CONSENT OF ITS OWNER.

	1	2	3	4	5	6	7	8	9	10																																																
A																																																										
B																																																										
C																																																										
D																																																										
E																																																										
F																																																										
G	<table><tr><td colspan="4">AS-BUILT BY _____ DATE _____</td><td colspan="2">CONTRACT NO. 11131113/00</td><td colspan="2">JOB ORDER NO. S-13656</td><td colspan="2">COMMON LEGENDS</td><td colspan="2"><div>الشركة الوطنية لنقل الكهرباء</div><div>نقل الكهرباء</div><div>National Grid sa</div></td></tr><tr><td colspan="2">01</td><td colspan="2">14 08</td><td colspan="2">FACTORY AS BUILT</td><td colspan="2">DRAWN BY RIZ</td><td colspan="2">CHECKED BY KVR</td><td colspan="2">13.8kV CAPACITOR BANK-2 PROT. PANEL</td></tr><tr><td colspan="2">00</td><td colspan="2">13 04</td><td colspan="2">FOR APPROVAL</td><td colspan="2">DATE STARTED 24.01.2013</td><td colspan="2">DATE COMPLETED</td><td colspan="2">S/S 8709-132/13.8KV IN AL-KHARJ CITY</td></tr><tr><td colspan="2">REV. NO.</td><td colspan="2">DATE</td><td colspan="2">DESCRIPTION</td><td colspan="2">OPRG. DEPT. CTPD</td><td colspan="2">ENG. DEPT. AUT-PSAC</td><td colspan="2">RIYADH SAUDI ARABIA</td></tr></table>										AS-BUILT BY _____ DATE _____				CONTRACT NO. 11131113/00		JOB ORDER NO. S-13656		COMMON LEGENDS		<div>الشركة الوطنية لنقل الكهرباء</div> <div>نقل الكهرباء</div> <div>National Grid sa</div>		01		14 08		FACTORY AS BUILT		DRAWN BY RIZ		CHECKED BY KVR		13.8kV CAPACITOR BANK-2 PROT. PANEL		00		13 04		FOR APPROVAL		DATE STARTED 24.01.2013		DATE COMPLETED		S/S 8709-132/13.8KV IN AL-KHARJ CITY		REV. NO.		DATE		DESCRIPTION		OPRG. DEPT. CTPD		ENG. DEPT. AUT-PSAC		RIYADH SAUDI ARABIA	
AS-BUILT BY _____ DATE _____				CONTRACT NO. 11131113/00		JOB ORDER NO. S-13656		COMMON LEGENDS		<div>الشركة الوطنية لنقل الكهرباء</div> <div>نقل الكهرباء</div> <div>National Grid sa</div>																																																
01		14 08		FACTORY AS BUILT		DRAWN BY RIZ		CHECKED BY KVR		13.8kV CAPACITOR BANK-2 PROT. PANEL																																																
00		13 04		FOR APPROVAL		DATE STARTED 24.01.2013		DATE COMPLETED		S/S 8709-132/13.8KV IN AL-KHARJ CITY																																																
REV. NO.		DATE		DESCRIPTION		OPRG. DEPT. CTPD		ENG. DEPT. AUT-PSAC		RIYADH SAUDI ARABIA																																																

LEGENDS

±R1

±R2

±R3

±IT

FL

BB RS±

BB CBF±/CBF±

R

CR

ECC

LOCAL

REMOTE

ON

OFF

A

T

S

CS

CT

LS

LT

LC

LO

RO

DC SUPPLY – MAIN PROTECTION

DC SUPPLY – SECONDARY PROTECTION

DC SUPPLY – BACK UP PROTECTION

DC SUPPLY – INTER TRIP

DC SUPPLY – FLASHING CIRCUIT

DC SUPPLY – BUS BAR – PROTECTION RESET

DC SUPPLY – CBF PROTECTION

RESET BUS – ALARM SYSTEM

CONTROL ROOM

ENERGY CONTROL CENTRE

THE LOCATION OF CONTROLLED DEVICE

ANY OTHER LOCATION NOT LOCAL

CB NORMALLY OPEN AUXILIARY CONTACT

CB NORMALLY CLOSED AUXILIARY CONTACT

COMMON

TEST POSITION

SERVICE POSITION

CLOSE IN SERVICE POSITION

CLOSE IN TEST POSITION

LOCAL SERVICE

LOCAL TEST

LOCAL CLOSE

LOCAL OPEN

REMOTE OPEN

NOTES

LABELS

LUGS

FERULLING

WHITE LABEL WITH BLACK LETTERING WILL BE PROVIDED FOR ALL MOUNTED APPARATUS EQUIPMENT IDENTIFICATION AND FUNCTION REFERENCE LABEL WILL BE PROVIDED FOR FRONT MOUNTED EQUIPMENTS OF THE PANEL AND EQUIPMENT IDENTIFICATION LABEL WILL BE PROVIDED FOR INTERNALLY MOUNTED EQUIPMENTS

A. CT CIRCUITS– RING TYPE

B. OTHER CIRCUITS – SPADE TYPE

YELLO TUBE 3.2 mm FOR 1.5SQ mm WIRES AND 4.2 FOR 2.5 SQ mm WIRES (AS PER 31 – TMSS–1, RE.0)

THIS DRAWING AND THE INFORMATION CONTAINED HEREIN ARE THE SOLE PROPERTY OF National Grid SA


NO REPRODUCTION IN FULL OR IN PART SHALL BE OBTAINED FROM THIS DOCUMENT WITHOUT THE WRITTEN CONSENT OF ITS OWNER.

NG/D2-D (2012/01)

DMS

VECTOR

NGD200

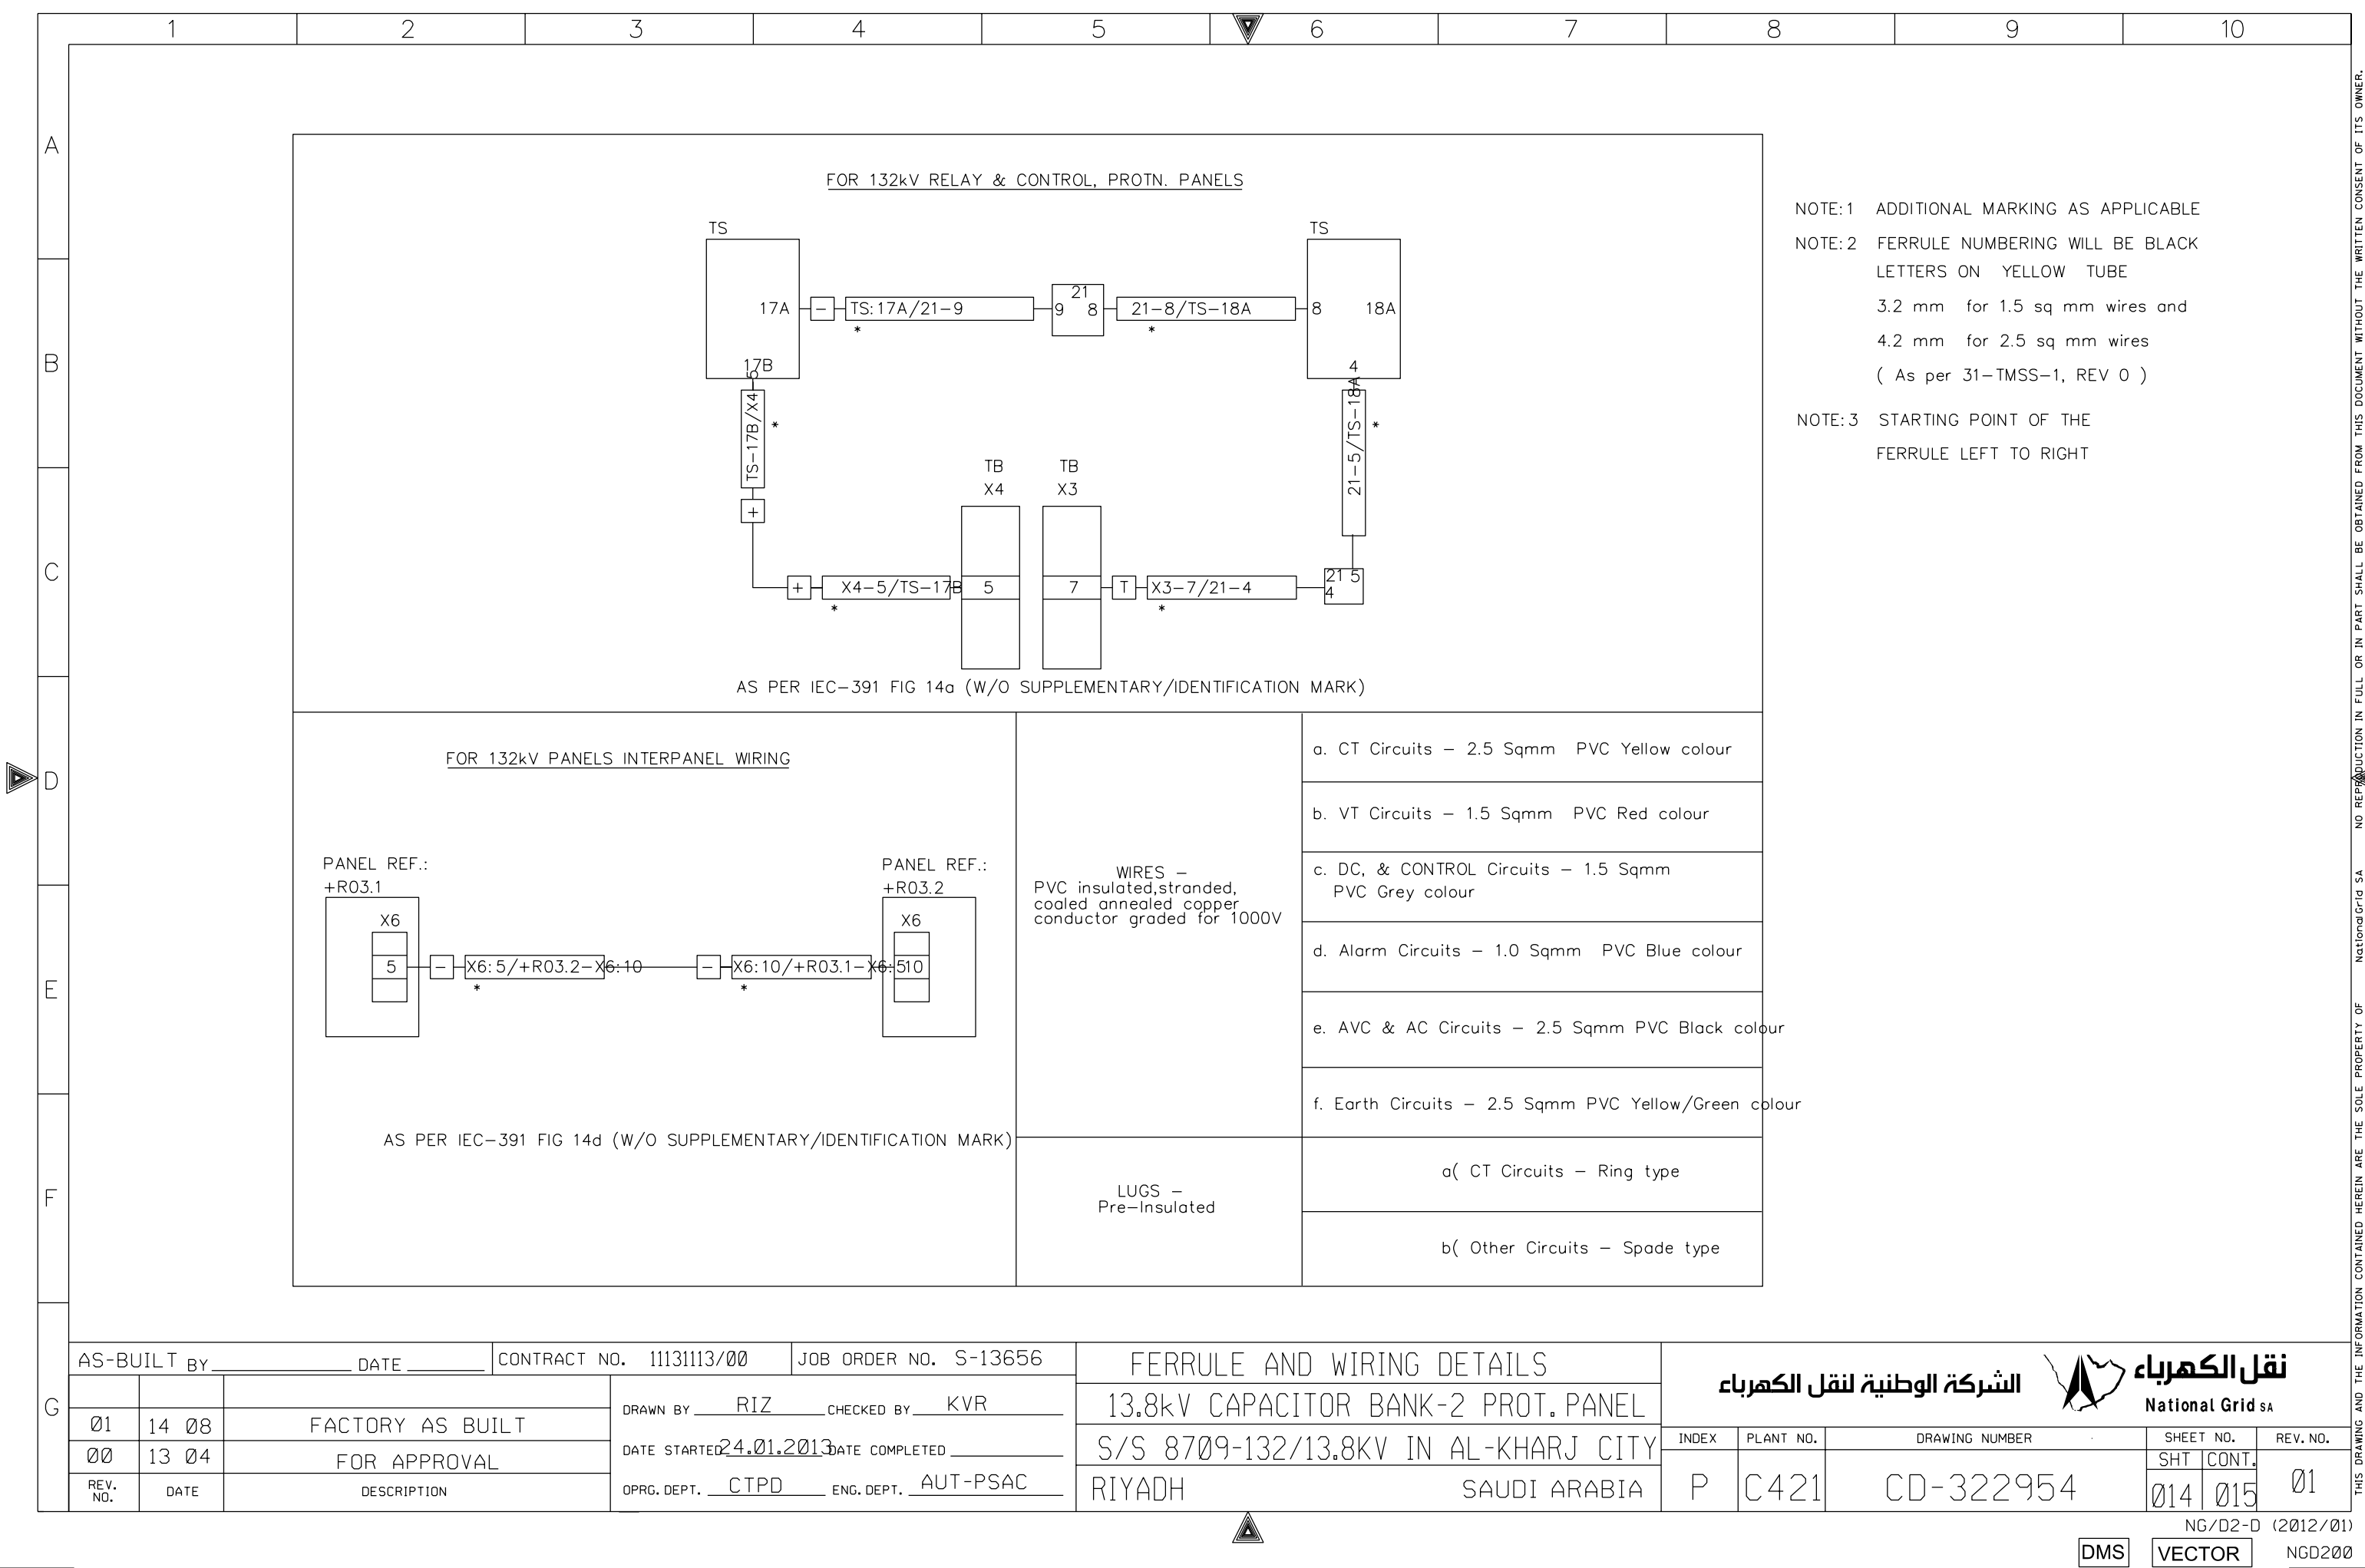

	1	2	3	4	5	6	7	8	9	10																																																																																															
A	<div><div>ABB</div><div>PROTECTION & SUBSTATION AUTOMATION</div></div> <table><thead><tr><th>MANUFACTURER</th><th>SCHEMATICS DWG.NO</th><th>PANEL DESCRIPTION</th><th>PANEL REFERENCE</th></tr></thead><tbody><tr><td rowspan="2"></td><td></td><td>SS 8709 132kV RELAY PANELS</td><td></td></tr><tr><td rowspan="2">CD-322928</td><td>132/13.8kV GT-1 RELAY PANEL -1</td><td>+R05.1</td></tr><tr><td></td><td>132/13.8kV GT-1 RELAY PANEL -2</td><td>+R05.2</td></tr><tr><td rowspan="2">CD-322931</td><td>132/13.8kV GT-2 RELAY PANEL -1</td><td>+R01.1</td></tr><tr><td></td><td>132/13.8kV GT-2 RELAY PANEL -2</td><td>+R01.2</td></tr><tr><td rowspan="2">CD-322934</td><td>132/13.8kV GT-3 RELAY PANEL -1</td><td>+R04.1</td></tr><tr><td></td><td>132/13.8kV GT-3 RELAY PANEL -2</td><td>+R04.2</td></tr><tr><td>CD-322936</td><td>132/13.8kV TRANSFORMER-1,2& 3 AVC PANEL</td><td>+AVC</td></tr><tr><td rowspan="2">CD-322922</td><td>132KV SPARE-1 UGF RELAY PANEL -1</td><td>+R07.1</td></tr><tr><td></td><td>132KV SPARE-1 UGF RELAY PANEL -2</td><td>+R07.2</td></tr><tr><td rowspan="2">CD-322916</td><td>132KV 8020 UGF RELAY PANEL -1</td><td>+R02.1</td></tr><tr><td></td><td>132KV 8020 UGF RELAY PANEL -2</td><td>+R02.2</td></tr><tr><td rowspan="2">CD-322919</td><td>132KV 8710 UGF RELAY PANEL -1</td><td>+R03.1</td></tr><tr><td></td><td>132KV 8710 UGF RELAY PANEL -2</td><td>+R03.2</td></tr><tr><td rowspan="2">CD-322925</td><td>132KV SPARE-2 UGF RELAY PANEL -1</td><td>+R06.1</td></tr><tr><td></td><td>132KV SPARE-2 UGF RELAY PANEL -2</td><td>+R06.2</td></tr><tr><td>CD-323012</td><td>132KV FOIP PANEL</td><td>+FOIP</td></tr><tr><td>CD-322946</td><td>132kV BUS COUPLER-A</td><td>+R130</td></tr><tr><td>CD-322948</td><td>132kV BUS COUPLER-B</td><td>+R230</td></tr><tr><td>CD-322950</td><td>132kV BUS SECTION</td><td>+R120</td></tr><tr><td>CD-322991</td><td>132kV BUSBAR PROTECTION MAIN-1 CENTRAL UNIT PANEL</td><td>+BB1-1</td></tr><tr><td>CD-322993</td><td>132kV BUSBAR PROTECTION MAIN-1 BAY UNIT PANEL</td><td>+BB1-2</td></tr><tr><td>CD-322995</td><td>132kV BUSBAR PROTECTION MAIN-1 BAY UNIT PANEL</td><td>+BB1-3</td></tr><tr><td>CD-322997</td><td>132kV BUSBAR PROTECTION MAIN-1 BAY UNIT PANEL</td><td>+BB1-4</td></tr><tr><td>CD-322999</td><td>132kV BUSBAR PROTECTION MAIN-1 BAY UNIT PANEL</td><td>+BB1-5</td></tr><tr><td>CD-323001</td><td>132kV BUSBAR PROTECTION MAIN-2 CENTRAL UNIT PANEL</td><td>+BB2-1</td></tr><tr><td>CD-323003</td><td>132kV BUSBAR PROTECTION MAIN-2 BAY UNIT PANEL</td><td>+BB2-2</td></tr><tr><td>CD-323005</td><td>132kV BUSBAR PROTECTION MAIN-2 BAY UNIT PANEL</td><td>+BB2-3</td></tr><tr><td>CD-323007</td><td>132kV BUSBAR PROTECTION MAIN-2 BAY UNIT PANEL</td><td>+BB2-4</td></tr><tr><td>CD-323009</td><td>132kV BUSBAR PROTECTION MAIN-2 BAY UNIT PANEL</td><td>+BB2-5</td></tr></tbody></table>										MANUFACTURER	SCHEMATICS DWG.NO	PANEL DESCRIPTION	PANEL REFERENCE			SS 8709 132kV RELAY PANELS		CD-322928	132/13.8kV GT-1 RELAY PANEL -1	+R05.1		132/13.8kV GT-1 RELAY PANEL -2	+R05.2	CD-322931	132/13.8kV GT-2 RELAY PANEL -1	+R01.1		132/13.8kV GT-2 RELAY PANEL -2	+R01.2	CD-322934	132/13.8kV GT-3 RELAY PANEL -1	+R04.1		132/13.8kV GT-3 RELAY PANEL -2	+R04.2	CD-322936	132/13.8kV TRANSFORMER-1,2& 3 AVC PANEL	+AVC	CD-322922	132KV SPARE-1 UGF RELAY PANEL -1	+R07.1		132KV SPARE-1 UGF RELAY PANEL -2	+R07.2	CD-322916	132KV 8020 UGF RELAY PANEL -1	+R02.1		132KV 8020 UGF RELAY PANEL -2	+R02.2	CD-322919	132KV 8710 UGF RELAY PANEL -1	+R03.1		132KV 8710 UGF RELAY PANEL -2	+R03.2	CD-322925	132KV SPARE-2 UGF RELAY PANEL -1	+R06.1		132KV SPARE-2 UGF RELAY PANEL -2	+R06.2	CD-323012	132KV FOIP PANEL	+FOIP	CD-322946	132kV BUS COUPLER-A	+R130	CD-322948	132kV BUS COUPLER-B	+R230	CD-322950	132kV BUS SECTION	+R120	CD-322991	132kV BUSBAR PROTECTION MAIN-1 CENTRAL UNIT PANEL	+BB1-1	CD-322993	132kV BUSBAR PROTECTION MAIN-1 BAY UNIT PANEL	+BB1-2	CD-322995	132kV BUSBAR PROTECTION MAIN-1 BAY UNIT PANEL	+BB1-3	CD-322997	132kV BUSBAR PROTECTION MAIN-1 BAY UNIT PANEL	+BB1-4	CD-322999	132kV BUSBAR PROTECTION MAIN-1 BAY UNIT PANEL	+BB1-5	CD-323001	132kV BUSBAR PROTECTION MAIN-2 CENTRAL UNIT PANEL	+BB2-1	CD-323003	132kV BUSBAR PROTECTION MAIN-2 BAY UNIT PANEL	+BB2-2	CD-323005	132kV BUSBAR PROTECTION MAIN-2 BAY UNIT PANEL	+BB2-3	CD-323007	132kV BUSBAR PROTECTION MAIN-2 BAY UNIT PANEL	+BB2-4	CD-323009	132kV BUSBAR PROTECTION MAIN-2 BAY UNIT PANEL	+BB2-5
MANUFACTURER											SCHEMATICS DWG.NO	PANEL DESCRIPTION	PANEL REFERENCE																																																																																												
												SS 8709 132kV RELAY PANELS																																																																																													
											CD-322928	132/13.8kV GT-1 RELAY PANEL -1	+R05.1																																																																																												
												132/13.8kV GT-1 RELAY PANEL -2	+R05.2																																																																																												
CD-322931											132/13.8kV GT-2 RELAY PANEL -1	+R01.1																																																																																													
												132/13.8kV GT-2 RELAY PANEL -2	+R01.2																																																																																												
CD-322934											132/13.8kV GT-3 RELAY PANEL -1	+R04.1																																																																																													
												132/13.8kV GT-3 RELAY PANEL -2	+R04.2																																																																																												
CD-322936											132/13.8kV TRANSFORMER-1,2& 3 AVC PANEL	+AVC																																																																																													
CD-322922											132KV SPARE-1 UGF RELAY PANEL -1	+R07.1																																																																																													
												132KV SPARE-1 UGF RELAY PANEL -2	+R07.2																																																																																												
CD-322916											132KV 8020 UGF RELAY PANEL -1	+R02.1																																																																																													
												132KV 8020 UGF RELAY PANEL -2	+R02.2																																																																																												
CD-322919											132KV 8710 UGF RELAY PANEL -1	+R03.1																																																																																													
												132KV 8710 UGF RELAY PANEL -2	+R03.2																																																																																												
CD-322925											132KV SPARE-2 UGF RELAY PANEL -1	+R06.1																																																																																													
												132KV SPARE-2 UGF RELAY PANEL -2	+R06.2																																																																																												
CD-323012											132KV FOIP PANEL	+FOIP																																																																																													
CD-322946											132kV BUS COUPLER-A	+R130																																																																																													
CD-322948	132kV BUS COUPLER-B	+R230																																																																																																							
CD-322950	132kV BUS SECTION	+R120																																																																																																							
CD-322991	132kV BUSBAR PROTECTION MAIN-1 CENTRAL UNIT PANEL	+BB1-1																																																																																																							
CD-322993	132kV BUSBAR PROTECTION MAIN-1 BAY UNIT PANEL	+BB1-2																																																																																																							
CD-322995	132kV BUSBAR PROTECTION MAIN-1 BAY UNIT PANEL	+BB1-3																																																																																																							
CD-322997	132kV BUSBAR PROTECTION MAIN-1 BAY UNIT PANEL	+BB1-4																																																																																																							
CD-322999	132kV BUSBAR PROTECTION MAIN-1 BAY UNIT PANEL	+BB1-5																																																																																																							
CD-323001	132kV BUSBAR PROTECTION MAIN-2 CENTRAL UNIT PANEL	+BB2-1																																																																																																							
CD-323003	132kV BUSBAR PROTECTION MAIN-2 BAY UNIT PANEL	+BB2-2																																																																																																							
CD-323005	132kV BUSBAR PROTECTION MAIN-2 BAY UNIT PANEL	+BB2-3																																																																																																							
CD-323007	132kV BUSBAR PROTECTION MAIN-2 BAY UNIT PANEL	+BB2-4																																																																																																							
CD-323009	132kV BUSBAR PROTECTION MAIN-2 BAY UNIT PANEL	+BB2-5																																																																																																							
B																																																																																																									
C																																																																																																									
D																																																																																																									
E																																																																																																									
F																																																																																																									
G	AS-BUILT BY _____ DATE _____		CONTRACT NO. 11131113/00		JOB ORDER NO. S-13656		DRAWING REFERENCES		<div>الشركة الوطنية لنقل الكهرباء</div> <div>نقل الكهرباء</div> <div>National Grid sa</div>																																																																																																
			DRAWN BY <u>RIZ</u> CHECKED BY <u>KVR</u>		13.8kV CAPACITOR BANK-2 PROT. PANEL		INDEX	PLANT NO.	DRAWING NUMBER	SHEET NO.	REV. NO.																																																																																														
	01	14 08	FACTORY AS BUILT		DATE STARTED <u>24.01.2013</u> DATE COMPLETED _____		P	C421	CD-322954	SHT	CONT.																																																																																														
	00	13 04	FOR APPROVAL		OPRG. DEPT. <u>CTPD</u> ENG. DEPT. <u>AUT-PSAC</u>					015	016	01																																																																																													
	REV. NO.	DATE	DESCRIPTION		RIYADH SAUDI ARABIA																																																																																																				




THIS DRAWING AND THE INFORMATION CONTAINED HEREIN ARE THE SOLE PROPERTY OF National Grid SA NO REPRODUCTION IN FULL OR IN PART SHALL BE OBTAINED FROM THIS DOCUMENT WITHOUT THE WRITTEN CONSENT OF ITS OWNER.


	1	2	3	4	5	6	7	8	9	10																																																																
A																																																																										
B																																																																										
C																																																																										
D																																																																										
E																																																																										
F																																																																										
G	<table><tr><td colspan="3">AS-BUILT BY _____ DATE _____</td><td colspan="2">CONTRACT NO. 11131113/00</td><td colspan="2">JOB ORDER NO. S-13656</td><td colspan="3">DRAWING REFERENCES</td><td colspan="2"><div>الشركة الوطنية لنقل الكهرباء</div><div>نقل الكهرباء</div><div>National Grid sa</div></td></tr><tr><td></td><td></td><td></td><td colspan="2">DRAWN BY <u>RIZ</u> CHECKED BY <u>KVR</u></td><td colspan="3">13.8kV CAPACITOR BANK-2 PROT.PANEL</td><td>INDEX</td><td>PLANT NO.</td><td>DRAWING NUMBER</td><td>SHEET NO.</td><td>REV. NO.</td></tr><tr><td></td><td>01</td><td>14 08</td><td colspan="2">FACTORY AS BUILT</td><td colspan="3">DATE STARTED <u>24.01.2013</u> DATE COMPLETED _____</td><td></td><td></td><td></td><td>SHT</td><td>CONT.</td></tr><tr><td></td><td>00</td><td>13 04</td><td colspan="2">FOR APPROVAL</td><td colspan="3">OPRG. DEPT. <u>CTPD</u> ENG. DEPT. <u>AUT-PSAC</u></td><td></td><td></td><td></td><td>016</td><td>211</td></tr><tr><td></td><td>REV. NO.</td><td>DATE</td><td colspan="2">DESCRIPTION</td><td colspan="3"></td><td>P</td><td>C421</td><td>CD-322954</td><td></td><td>01</td></tr></table>										AS-BUILT BY _____ DATE _____			CONTRACT NO. 11131113/00		JOB ORDER NO. S-13656		DRAWING REFERENCES			<div>الشركة الوطنية لنقل الكهرباء</div> <div>نقل الكهرباء</div> <div>National Grid sa</div>					DRAWN BY <u>RIZ</u> CHECKED BY <u>KVR</u>		13.8kV CAPACITOR BANK-2 PROT.PANEL			INDEX	PLANT NO.	DRAWING NUMBER	SHEET NO.	REV. NO.		01	14 08	FACTORY AS BUILT		DATE STARTED <u>24.01.2013</u> DATE COMPLETED _____						SHT	CONT.		00	13 04	FOR APPROVAL		OPRG. DEPT. <u>CTPD</u> ENG. DEPT. <u>AUT-PSAC</u>						016	211		REV. NO.	DATE	DESCRIPTION					P	C421	CD-322954		01
AS-BUILT BY _____ DATE _____			CONTRACT NO. 11131113/00		JOB ORDER NO. S-13656		DRAWING REFERENCES			<div>الشركة الوطنية لنقل الكهرباء</div> <div>نقل الكهرباء</div> <div>National Grid sa</div>																																																																
			DRAWN BY <u>RIZ</u> CHECKED BY <u>KVR</u>		13.8kV CAPACITOR BANK-2 PROT.PANEL			INDEX	PLANT NO.	DRAWING NUMBER	SHEET NO.	REV. NO.																																																														
	01	14 08	FACTORY AS BUILT		DATE STARTED <u>24.01.2013</u> DATE COMPLETED _____						SHT	CONT.																																																														
	00	13 04	FOR APPROVAL		OPRG. DEPT. <u>CTPD</u> ENG. DEPT. <u>AUT-PSAC</u>						016	211																																																														
	REV. NO.	DATE	DESCRIPTION					P	C421	CD-322954		01																																																														




PROTECTION & SUBSTATION
AUTOMATION

THIS DRAWING AND THE INFORMATION CONTAINED HEREIN ARE THE SOLE PROPERTY OF National Grid SA NO REPRODUCTION IN FULL OR IN PART SHALL BE OBTAINED FROM THIS DOCUMENT WITHOUT THE WRITTEN CONSENT OF ITS OWNER.

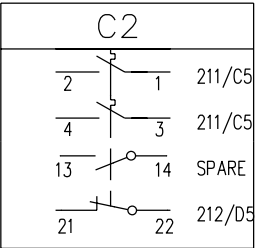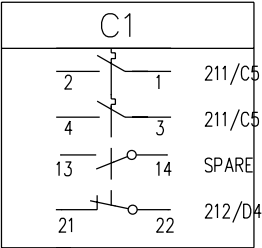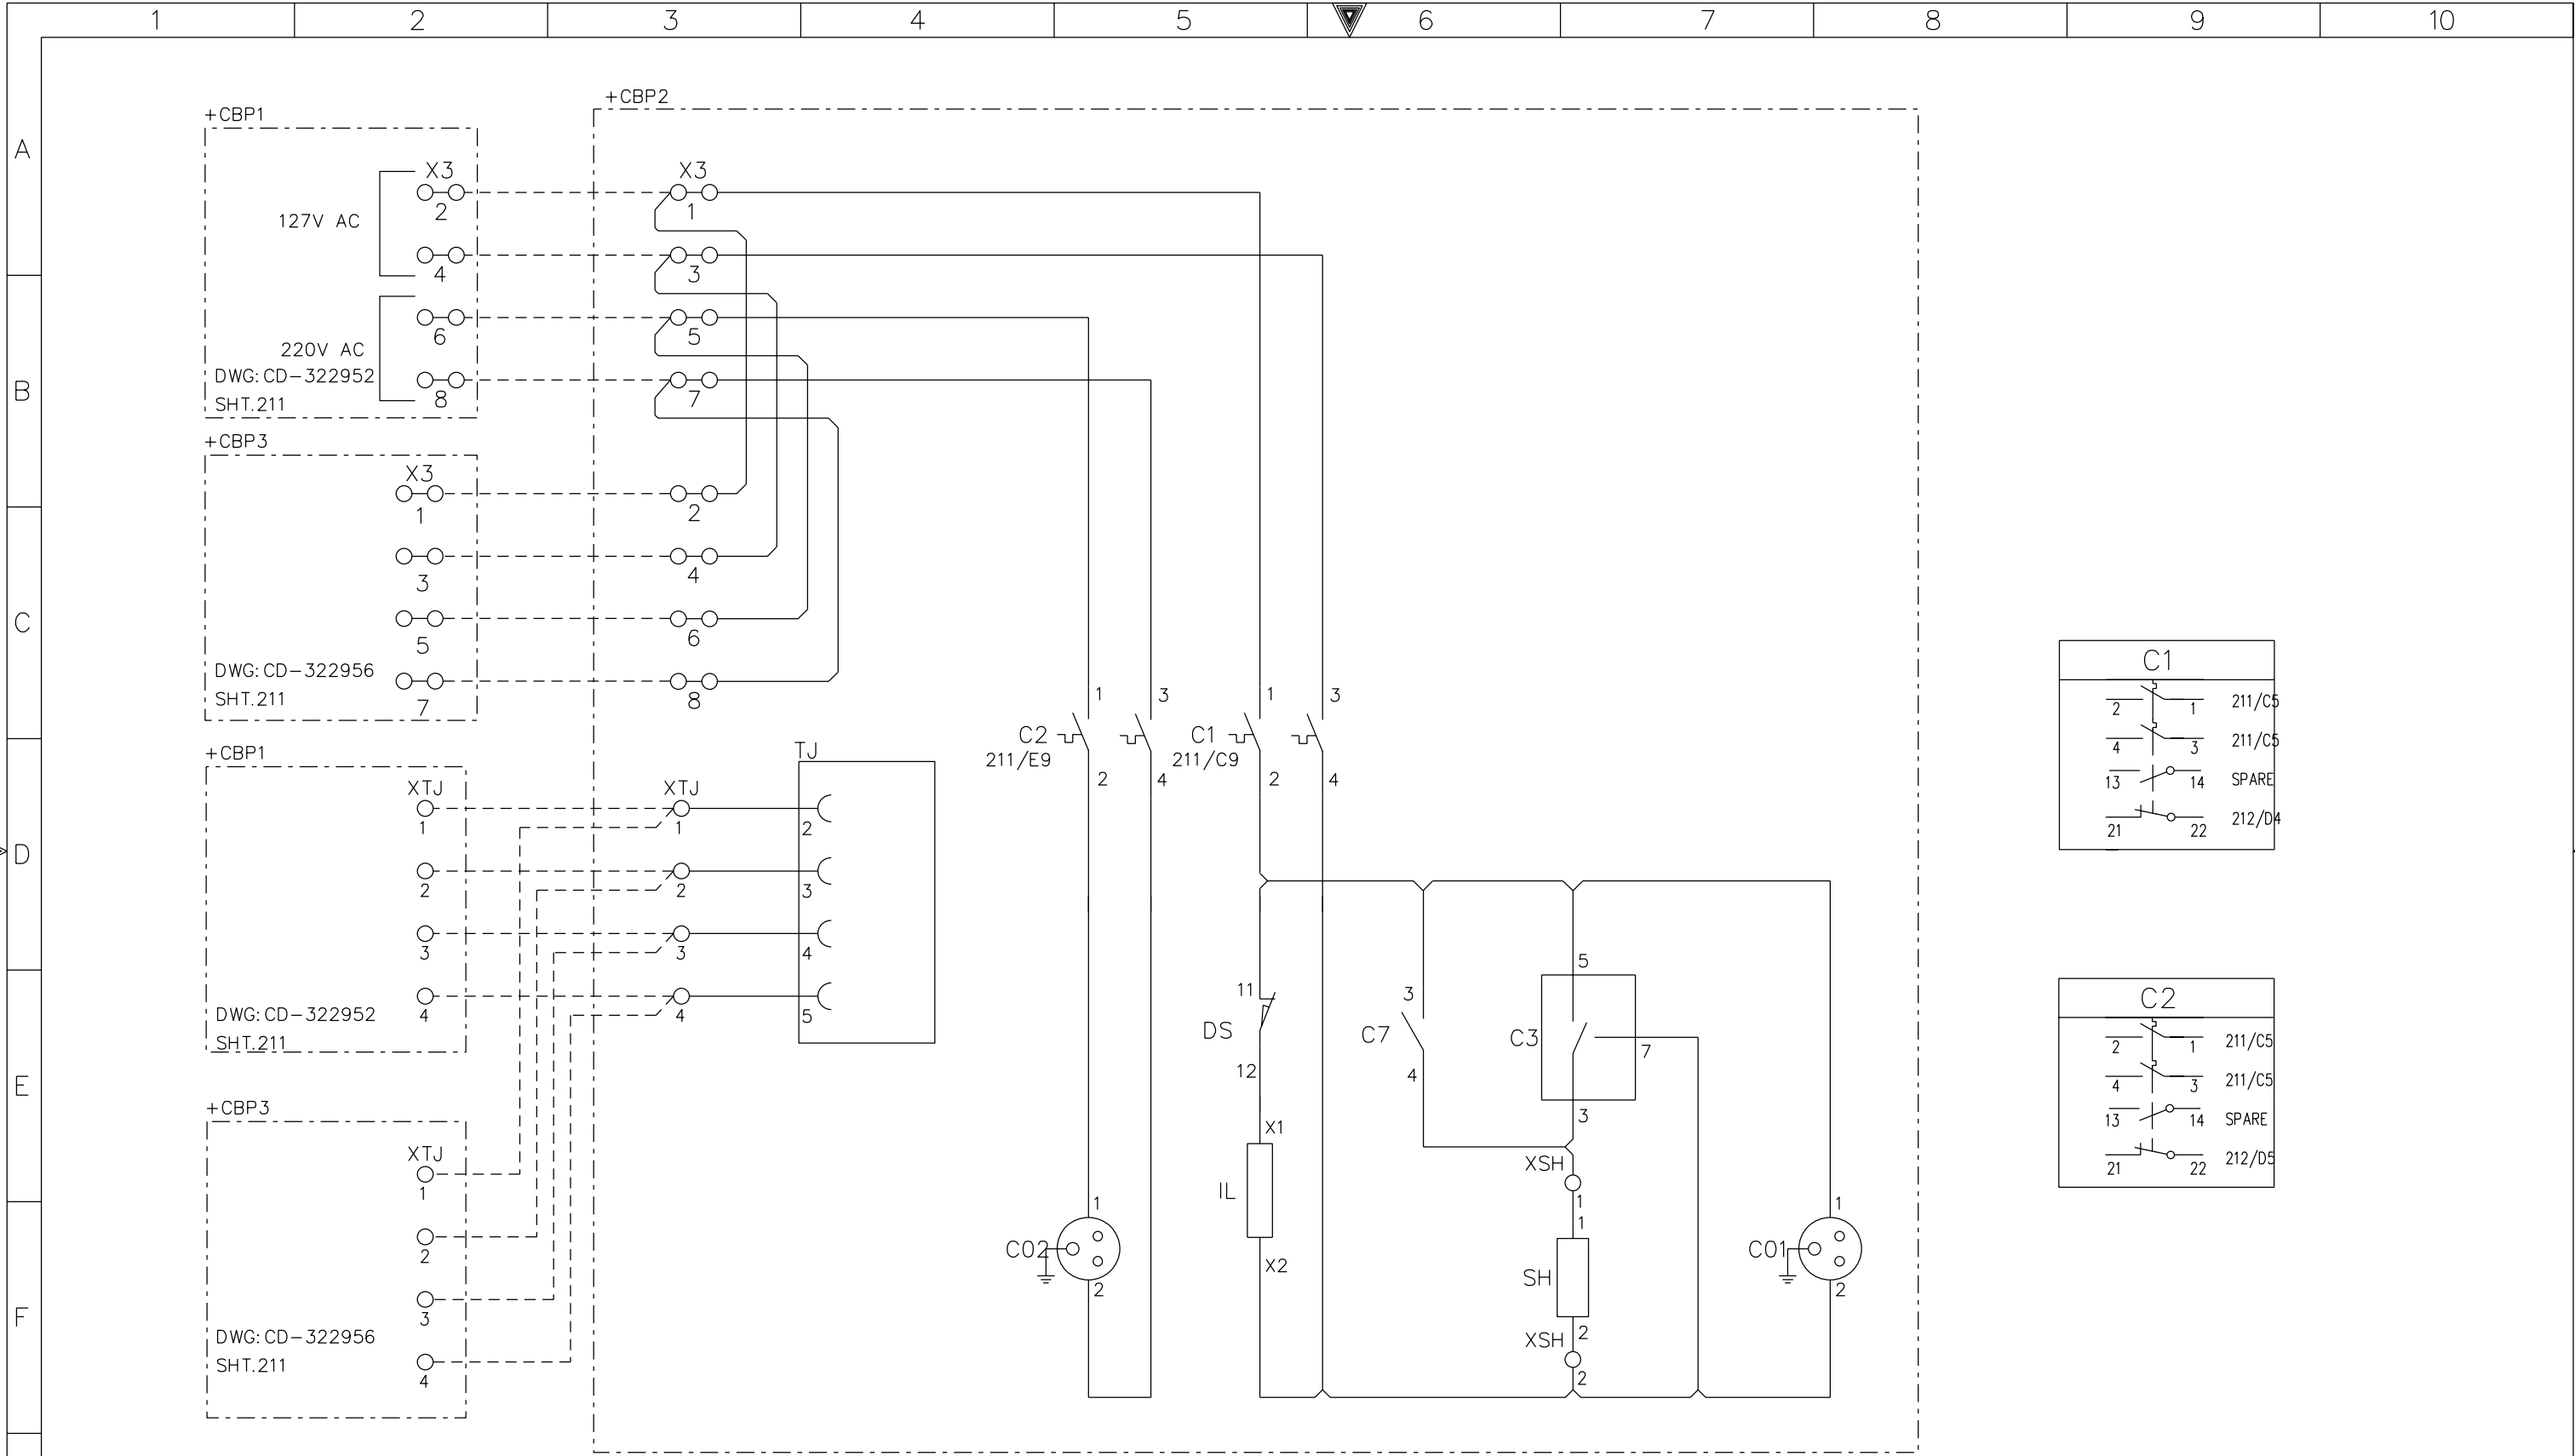


G	AS-BUILT BY _____ DATE _____		CONTRACT NO. 11131113/00		JOB ORDER NO. S-13656		AC SUPPLY FOR ILLUMINATION & POWER SOCKET		<div><div>الشركة الوطنية لنقل الكهرباء</div><div>نقل الكهرباء</div><div>National Grid SA</div></div>				
	01	14 08	FACTORY AS BUILT		DRAWN BY RIZ CHECKED BY KVR		13.8kV CAPACITOR BANK-2 PROT. PANEL						
	00	13 04	FOR APPROVAL		DATE STARTED 24.01.2013 DATE COMPLETED _____		S/S 8709-132/13.8KV IN AL-KHARJ CITY						
	REV. NO.	DATE	DESCRIPTION		OPRG. DEPT. CTPD ENG. DEPT. AUT-PSAC		RIYADH SAUDI ARABIA						
INDEX		PLANT NO.		DRAWING NUMBER		SHEET NO.		REV. NO.					
P		C421		CD-322954		SHT 211 CONT. 212		01					

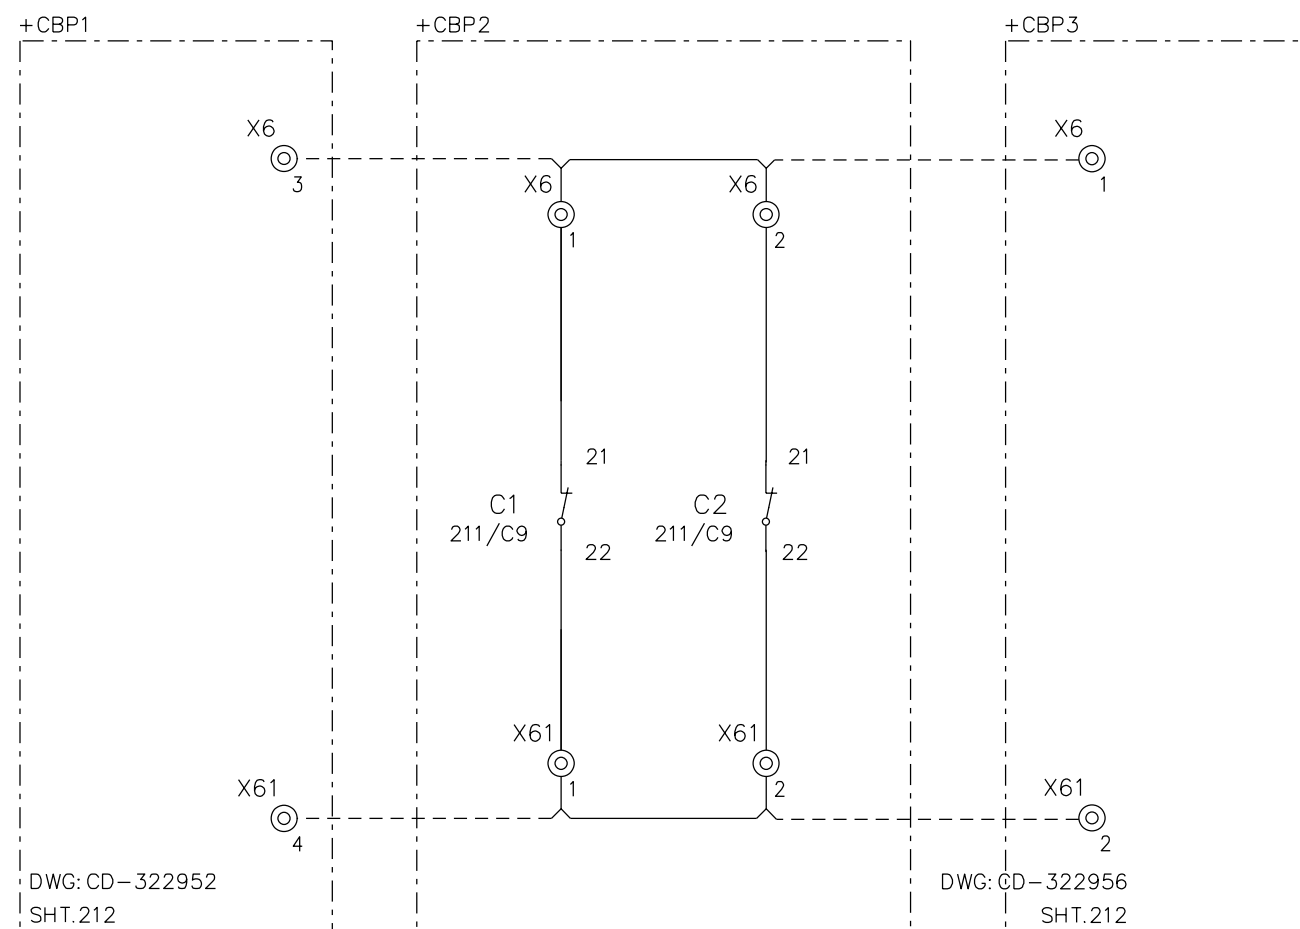

AS-BUILT BY _____ DATE _____		CONTRACT NO. 11131113/00		JOB ORDER NO. S-13656	
01	14 08	FACTORY AS BUILT		DRAWN BY <u>RIZ</u> CHECKED BY <u>KVR</u>	
00	13 04	FOR APPROVAL		DATE STARTED <u>24.01.2013</u> DATE COMPLETED _____	
REV. NO.	DATE	DESCRIPTION		OPRG. DEPT. <u>CTPD</u> ENG. DEPT. <u>AUT-PSAC</u>	

AC SUPPLY AUXILARY CONTACTS
13.8kV CAPACITOR BANK-2 PROT.PANEL
S/S 8709-132/13.8KV IN AL-KHARJ CITY
RIYADH SAUDI ARABIA

				نقل الكهرباء National Grid SA		الشركة الوطنية لنقل الكهرباء	
INDEX	PLANT NO.	DRAWING NUMBER		SHEET NO.		REV. NO.	
P	C421	CD-322954		SHT	CONT.	01	
				212	213		

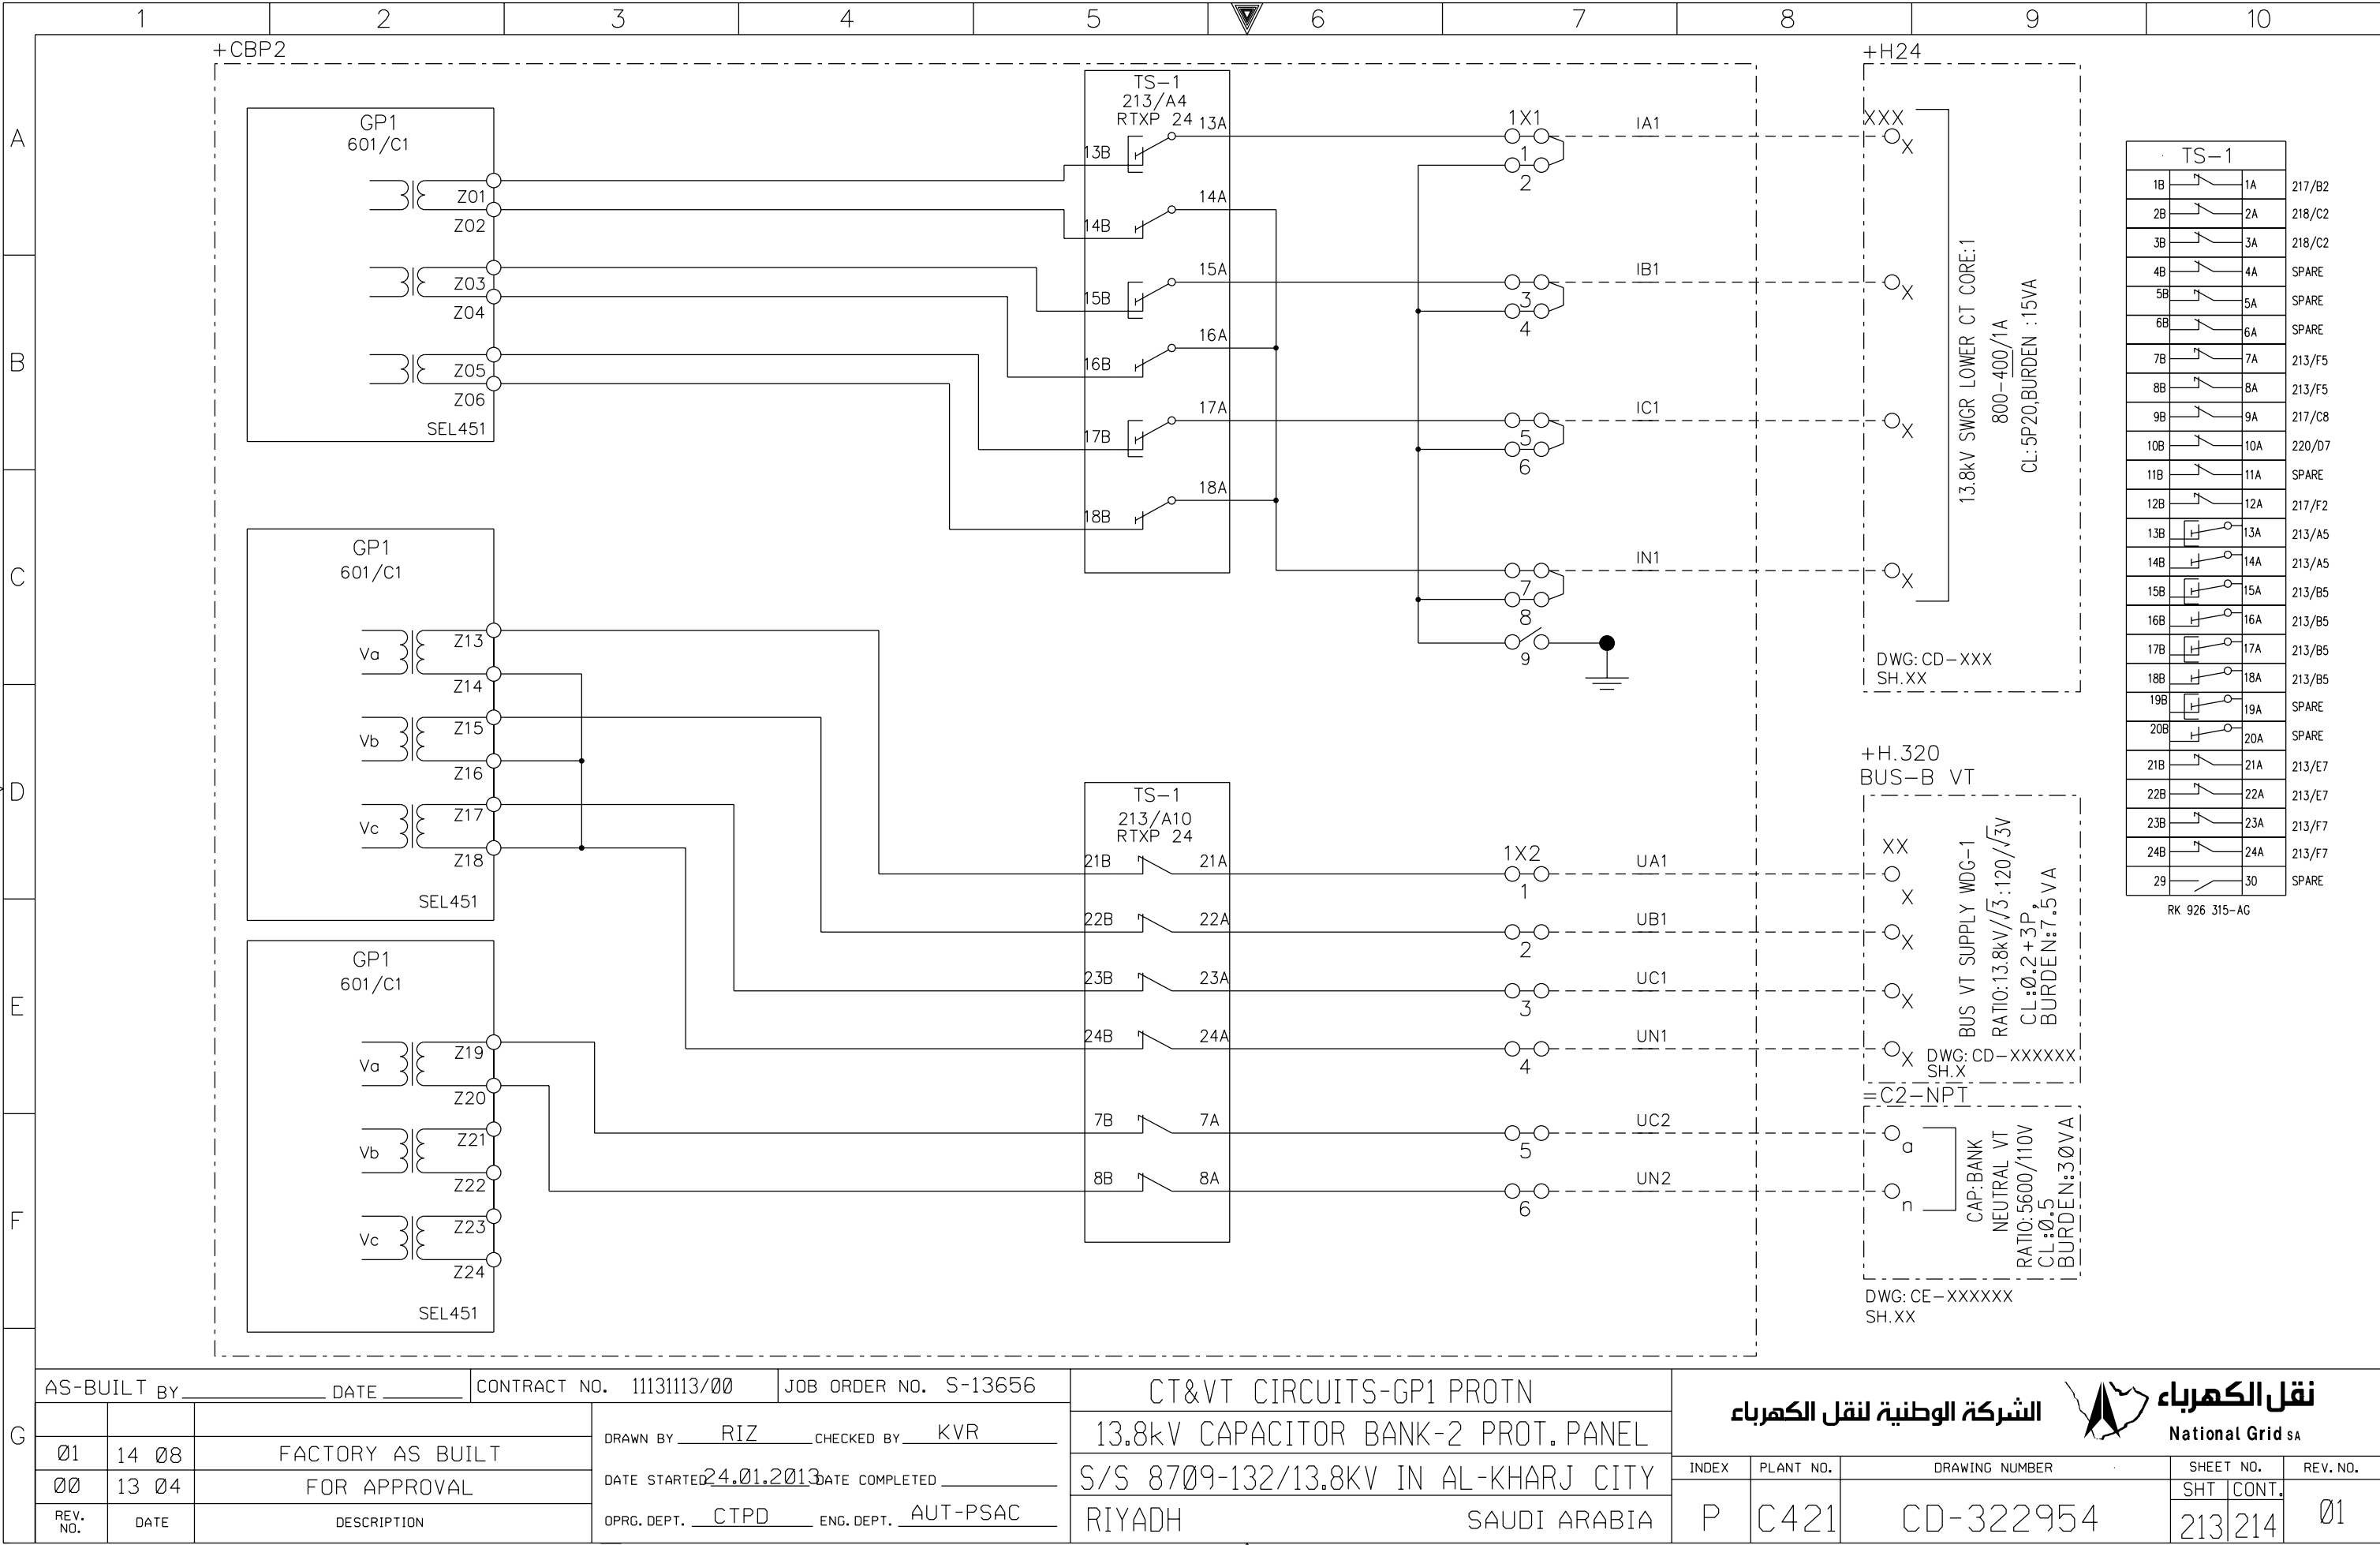


AS-BUILT BY _____ DATE _____ CONTRACT NO. 11131113/00 JOB ORDER NO. S-13656


G	01	14 08	FACTORY AS BUILT	DRAWN BY RIZ CHECKED BY KVR
	00	13 04	FOR APPROVAL	DATE STARTED 24.01.2013 DATE COMPLETED _____
	REV. NO.	DATE	DESCRIPTION	OPRG. DEPT. CTPD ENG. DEPT. AUT-PSAC

CT&VT CIRCUITS-GP1 PROT N
13.8kV CAPACITOR BANK-2 PROT. PANEL
S/S 8709-132/13.8KV IN AL-KHARJ CITY
RIYADH SAUDI ARABIA

الشركة الوطنية لنقل الكهرباء National Grid sa				
INDEX	PLANT NO.	DRAWING NUMBER	SHEET NO.	REV. NO.
P	C421	CD-322954	SHT 213	CONT. 214
			01	

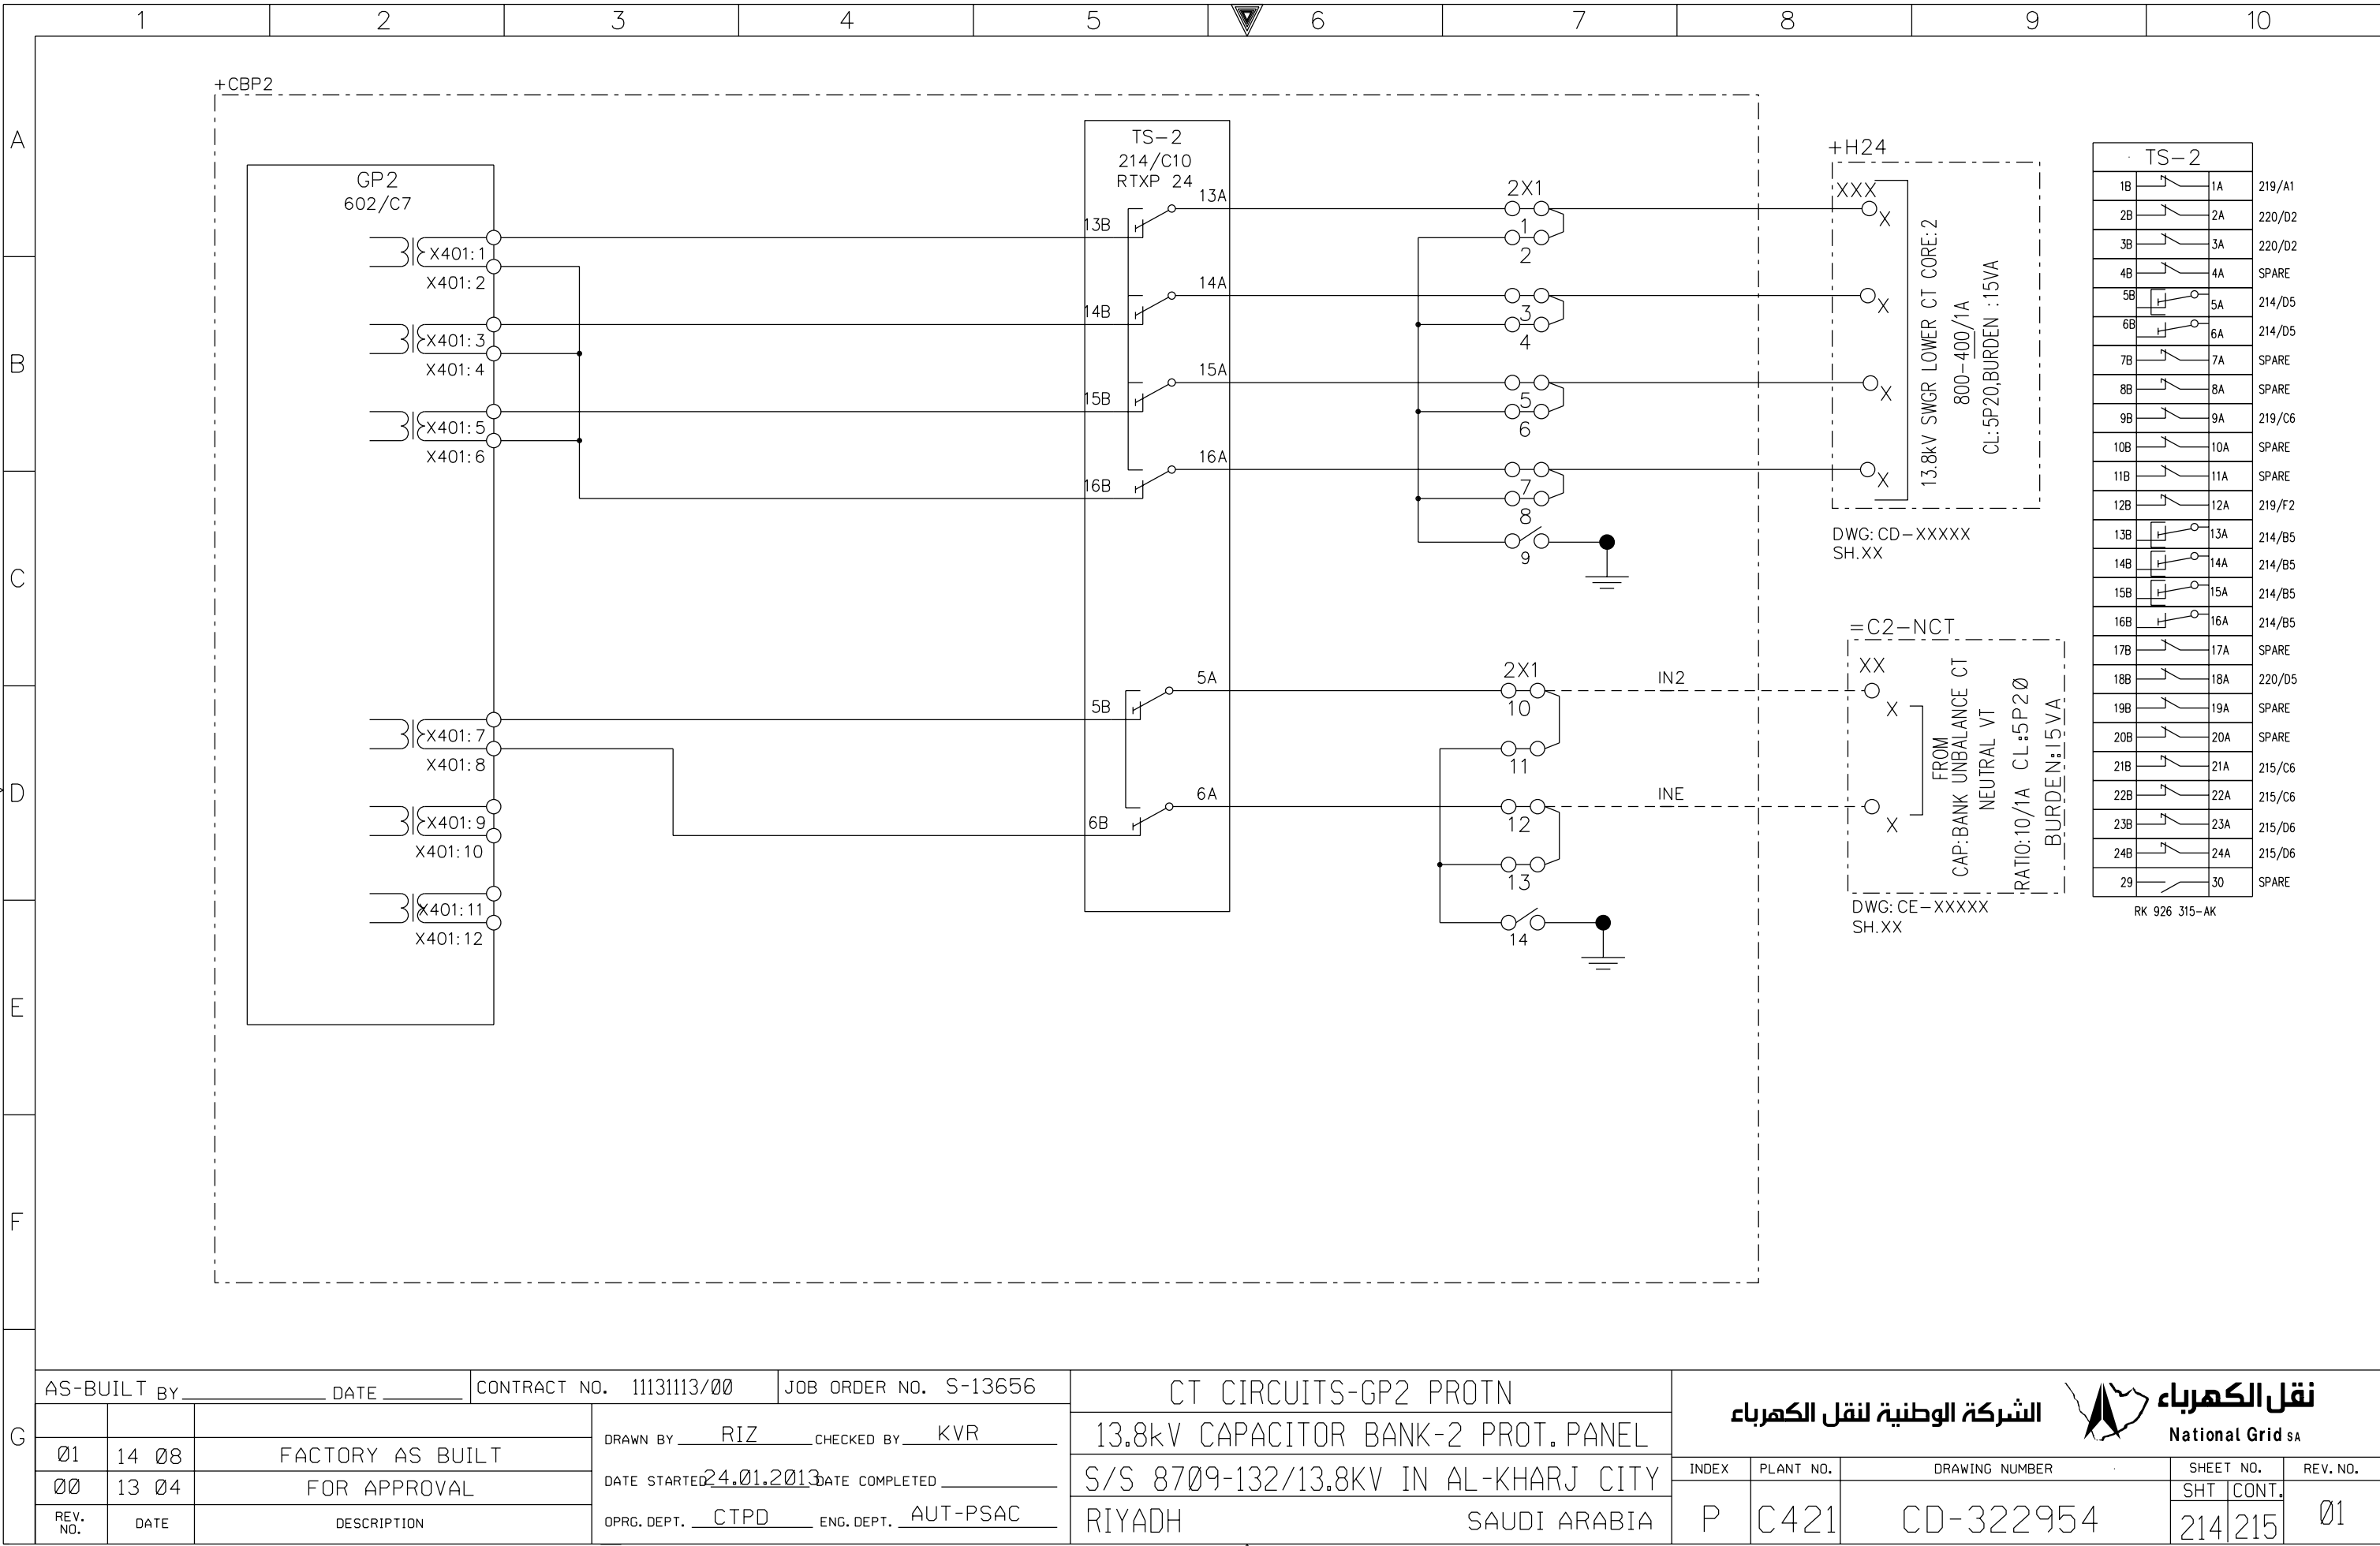

THIS DRAWING AND THE INFORMATION CONTAINED HEREIN ARE THE SOLE PROPERTY OF National Grid SA NO REPRODUCTION IN FULL OR IN PART SHALL BE OBTAINED FROM THIS DOCUMENT WITHOUT THE WRITTEN CONSENT OF ITS OWNER.

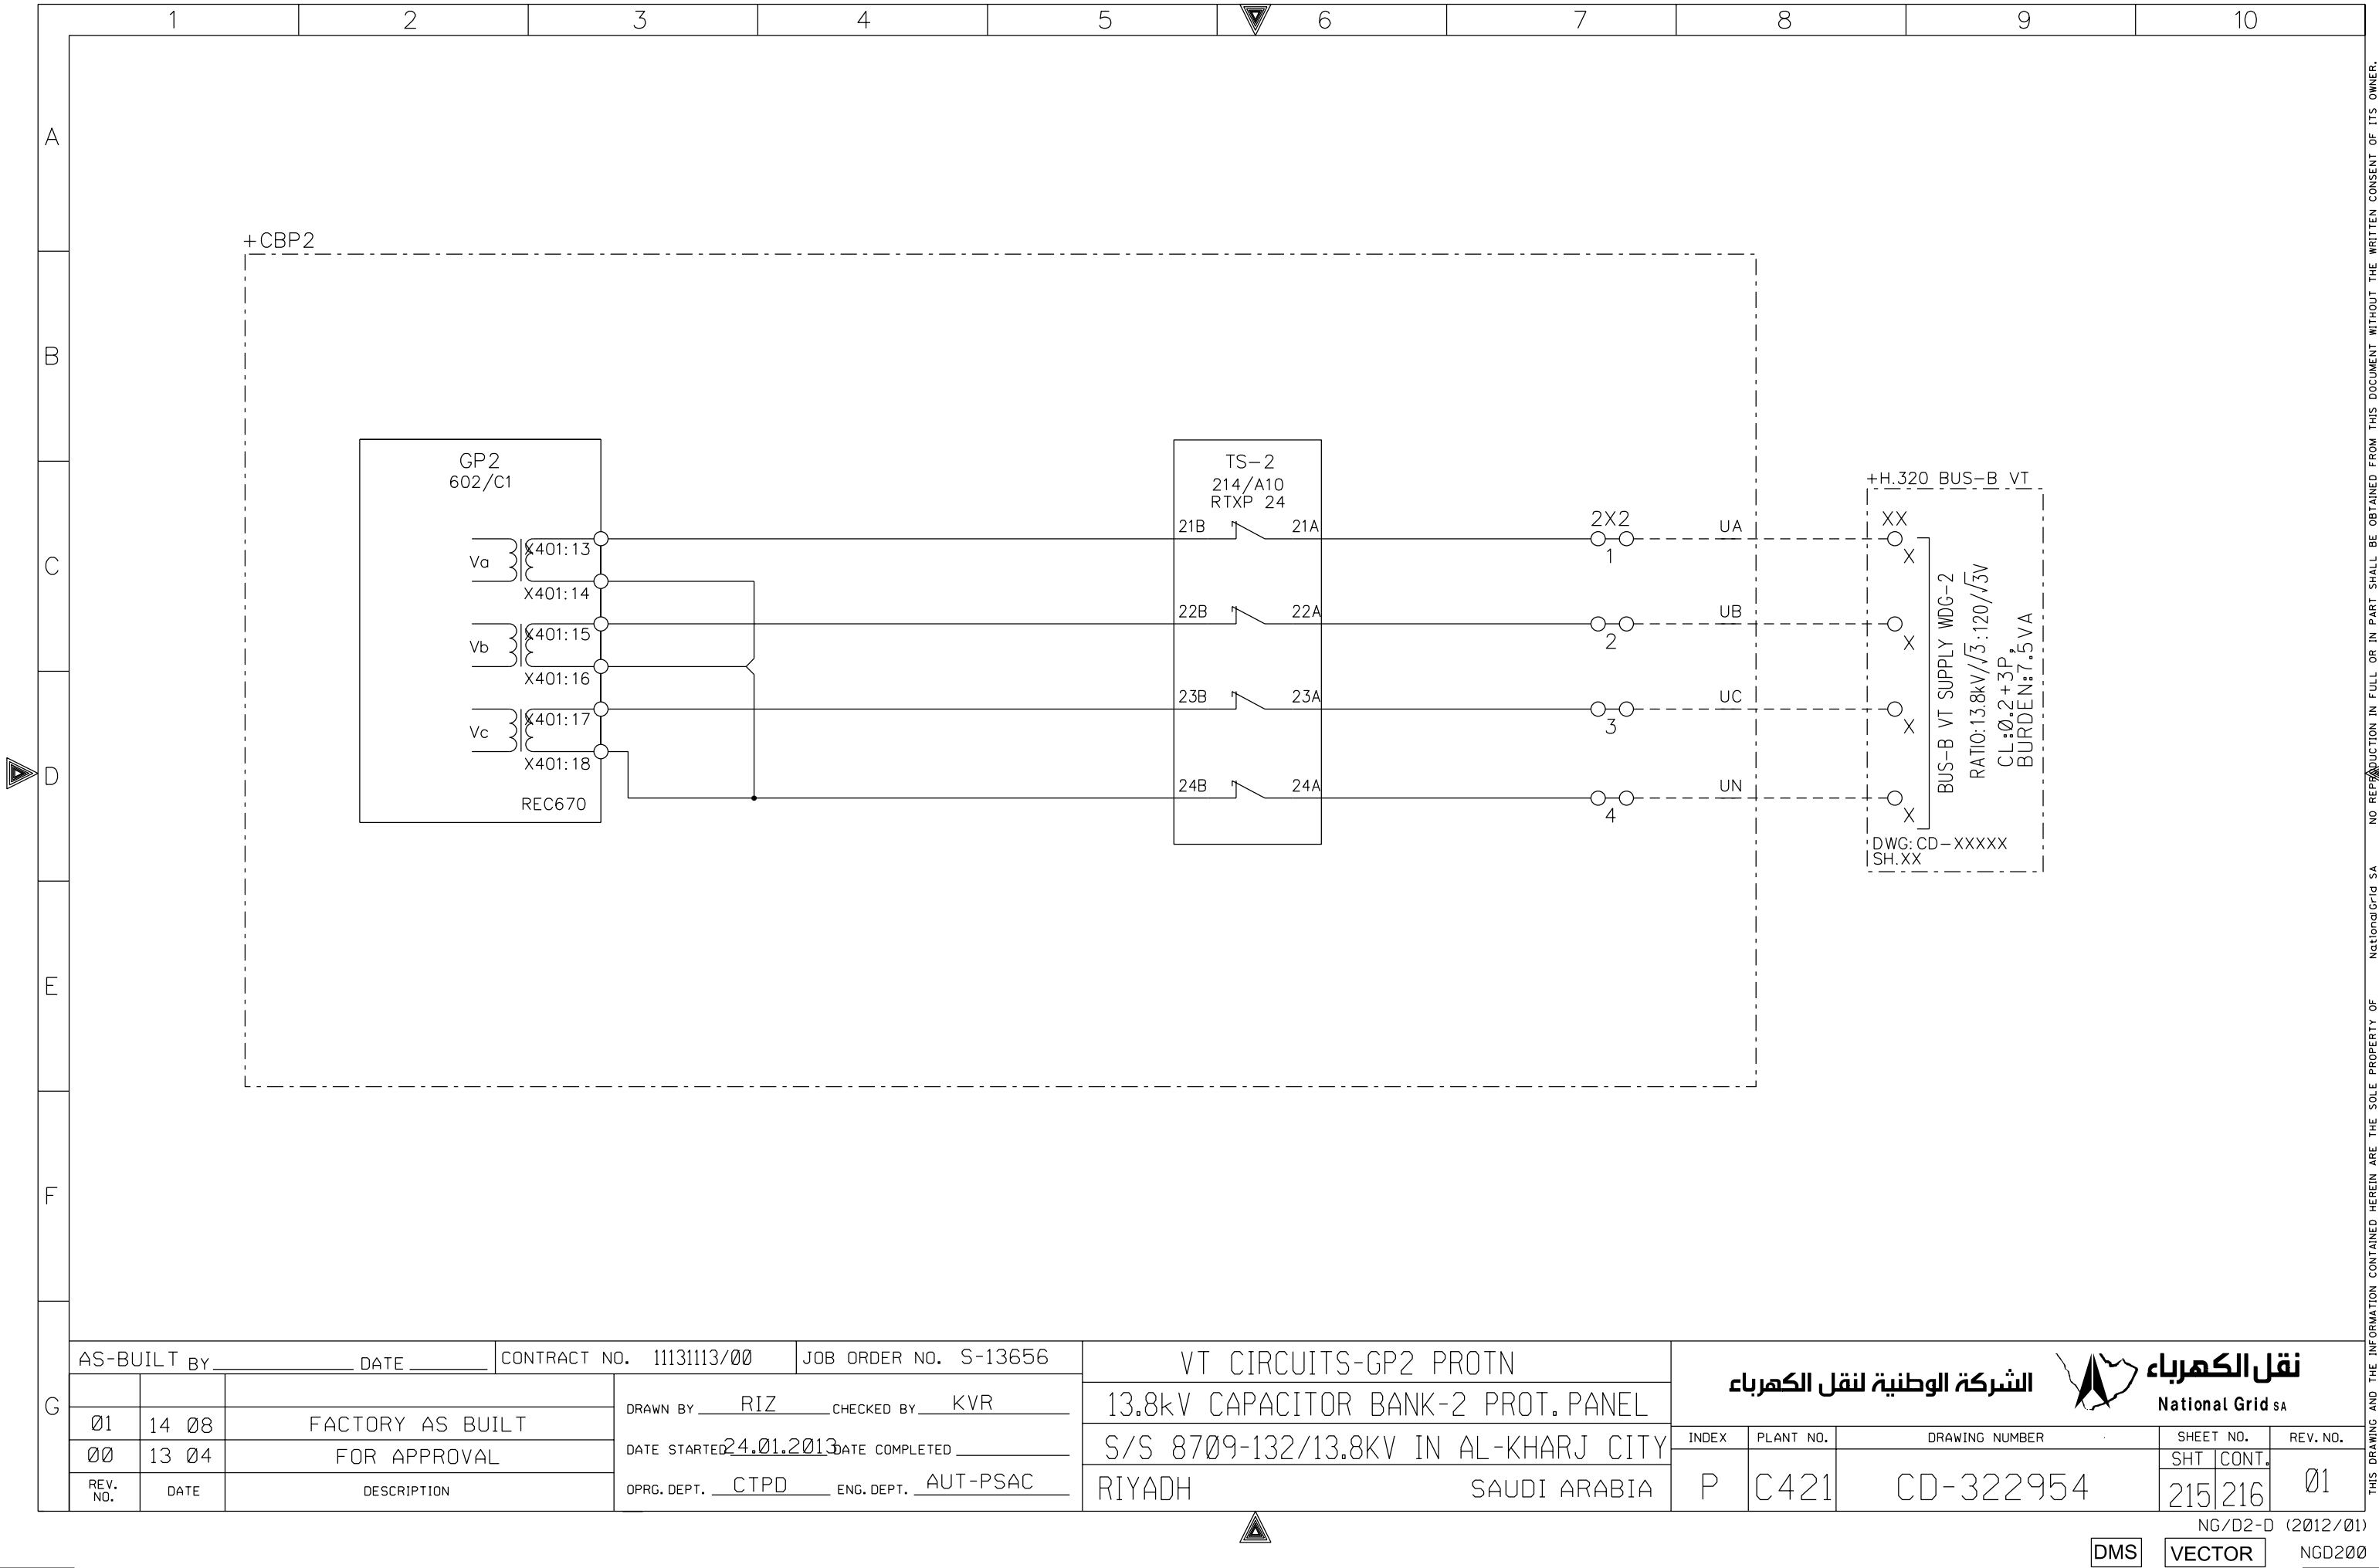



AS-BUILT BY _____ DATE _____ CONTRACT NO. 11131113/00 JOB ORDER NO. S-13656

01	14 08	FACTORY AS BUILT	DRAWN BY RIZ	CHECKED BY KVR
00	13 04	FOR APPROVAL	DATE STARTED 24.01.2013	DATE COMPLETED
REV. NO.	DATE	DESCRIPTION	OPRG. DEPT. CTPD	ENG. DEPT. AUT-PSAC


VT CIRCUITS-GP2 PROTN
13.8kV CAPACITOR BANK-2 PROT. PANEL
S/S 8709-132/13.8KV IN AL-KHARJ CITY
RIYADH SAUDI ARABIA

الشركة الوطنية لنقل الكهرباء		نقل الكهرباء		National Grid sa	
INDEX	PLANT NO.	DRAWING NUMBER		SHEET NO.	
P	C421	CD-322954		SHT	CONT.
				215	216
				01	

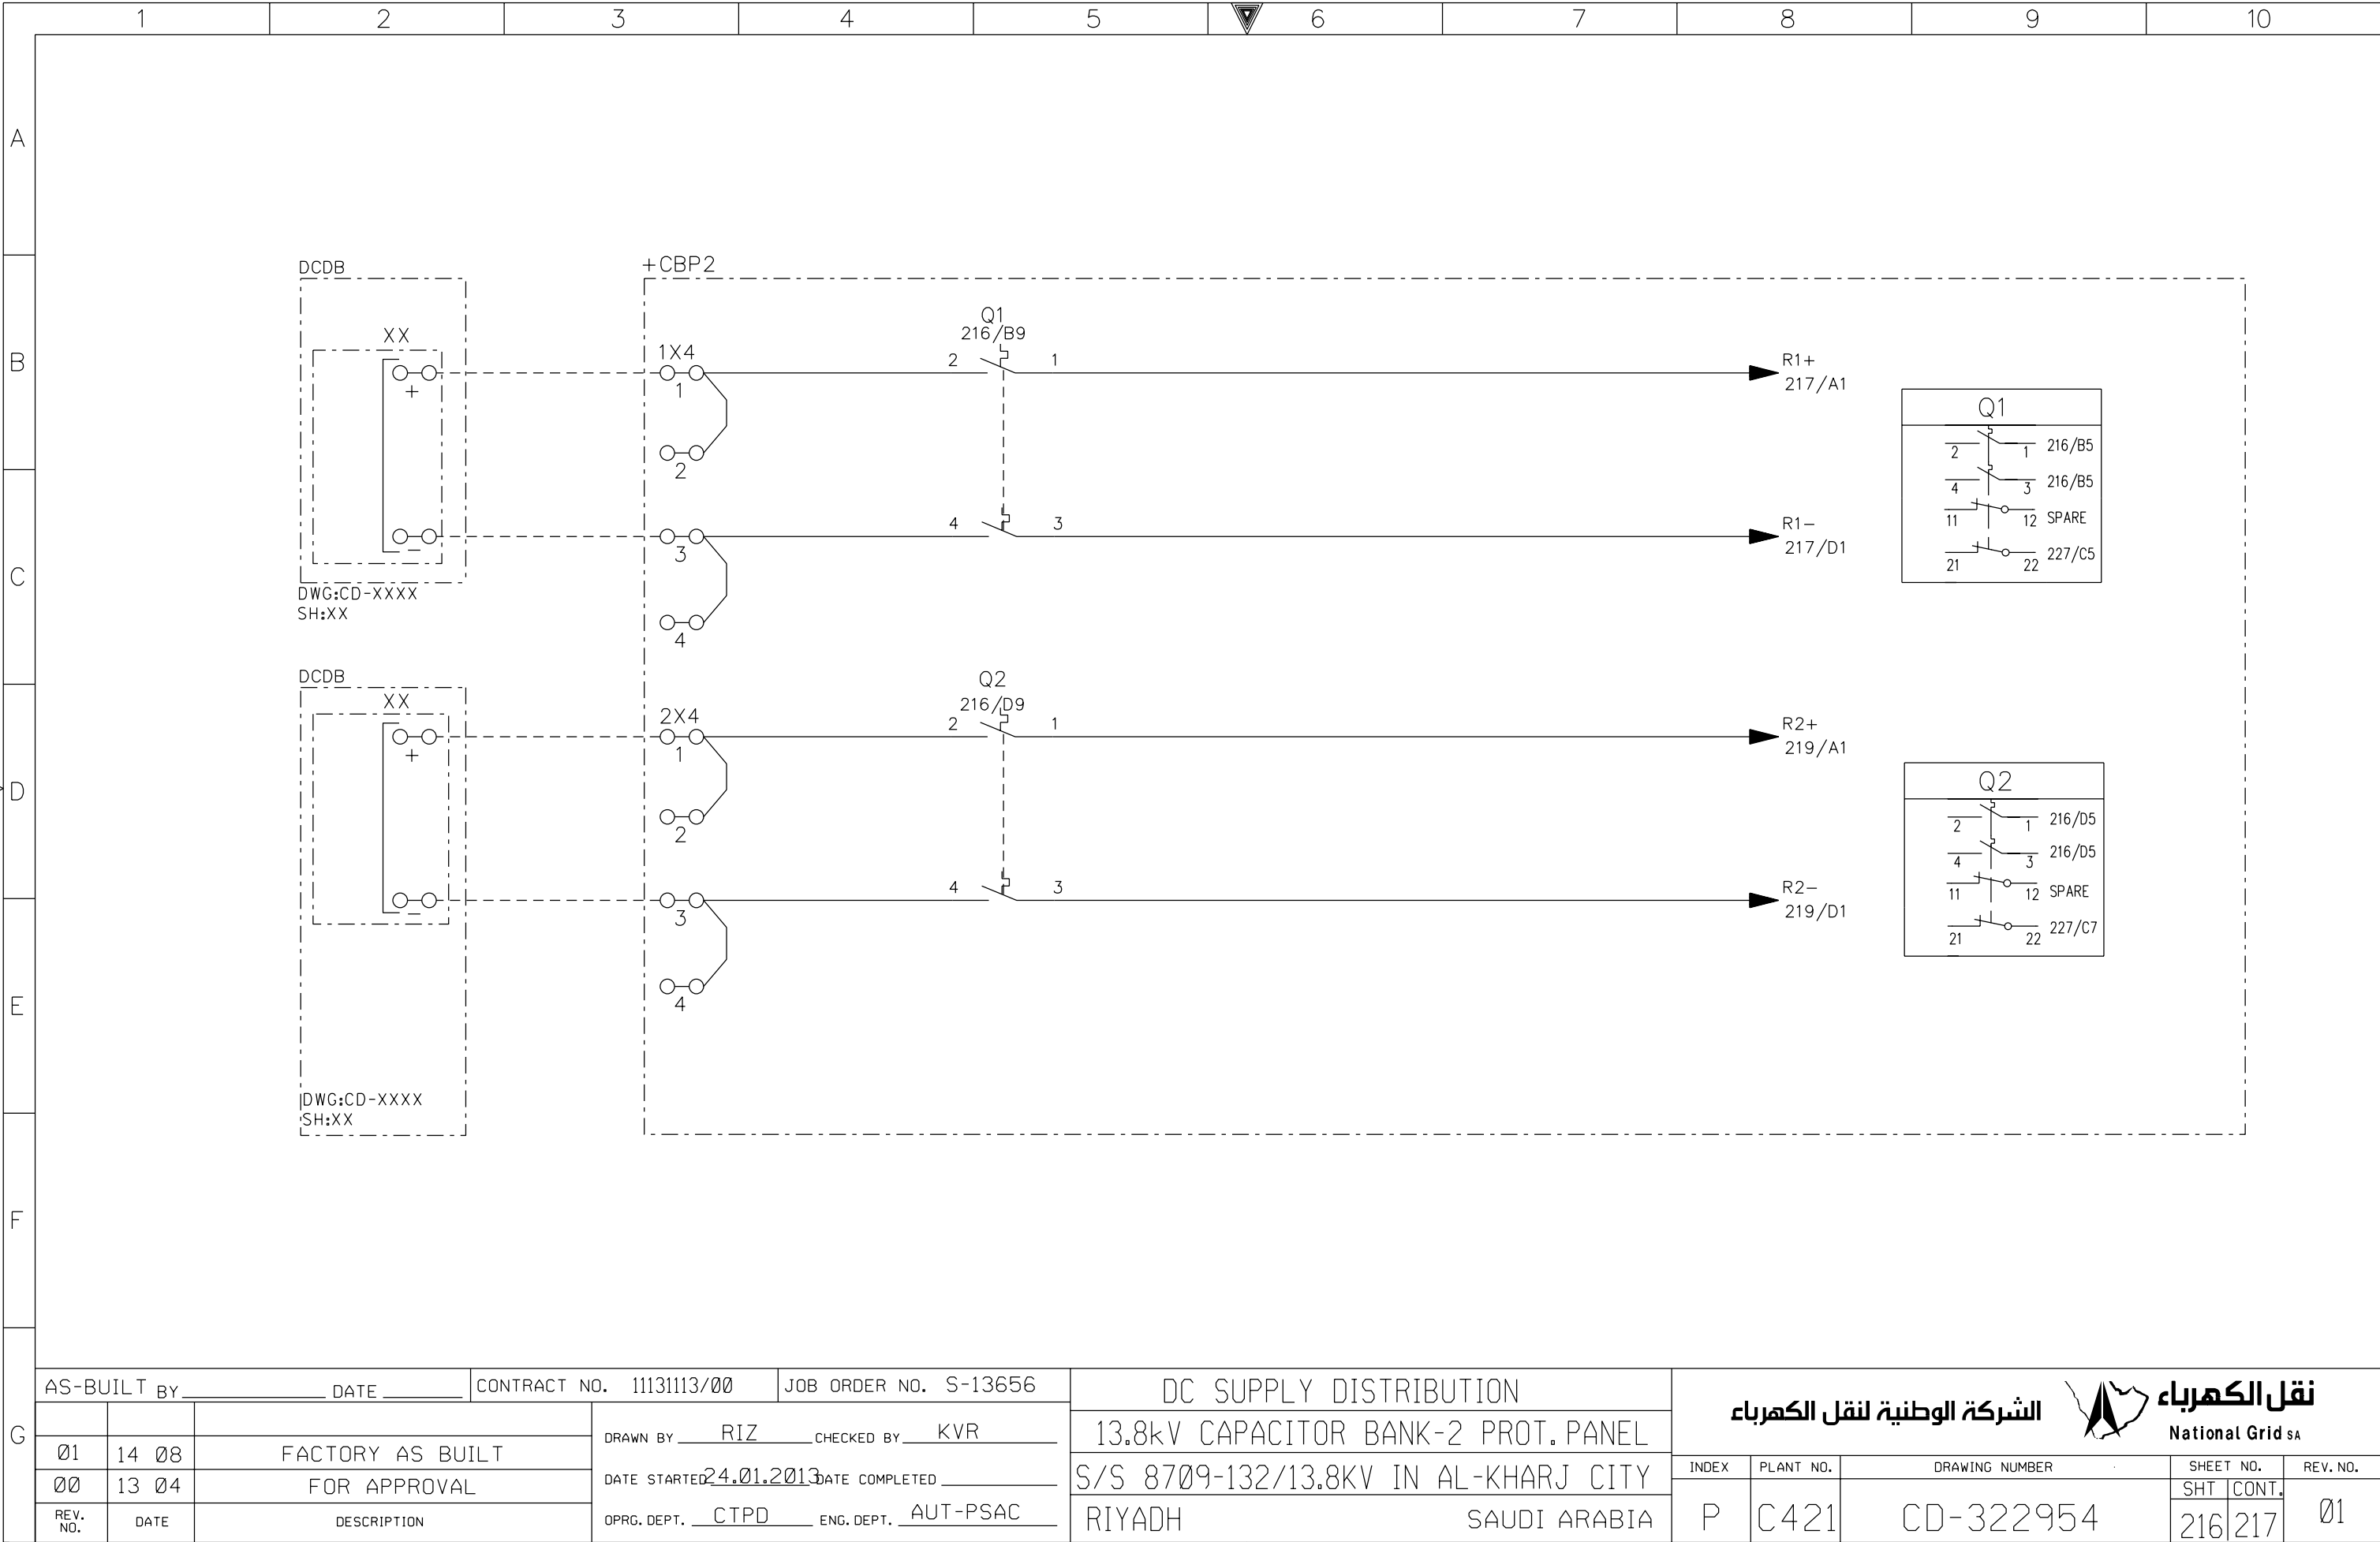


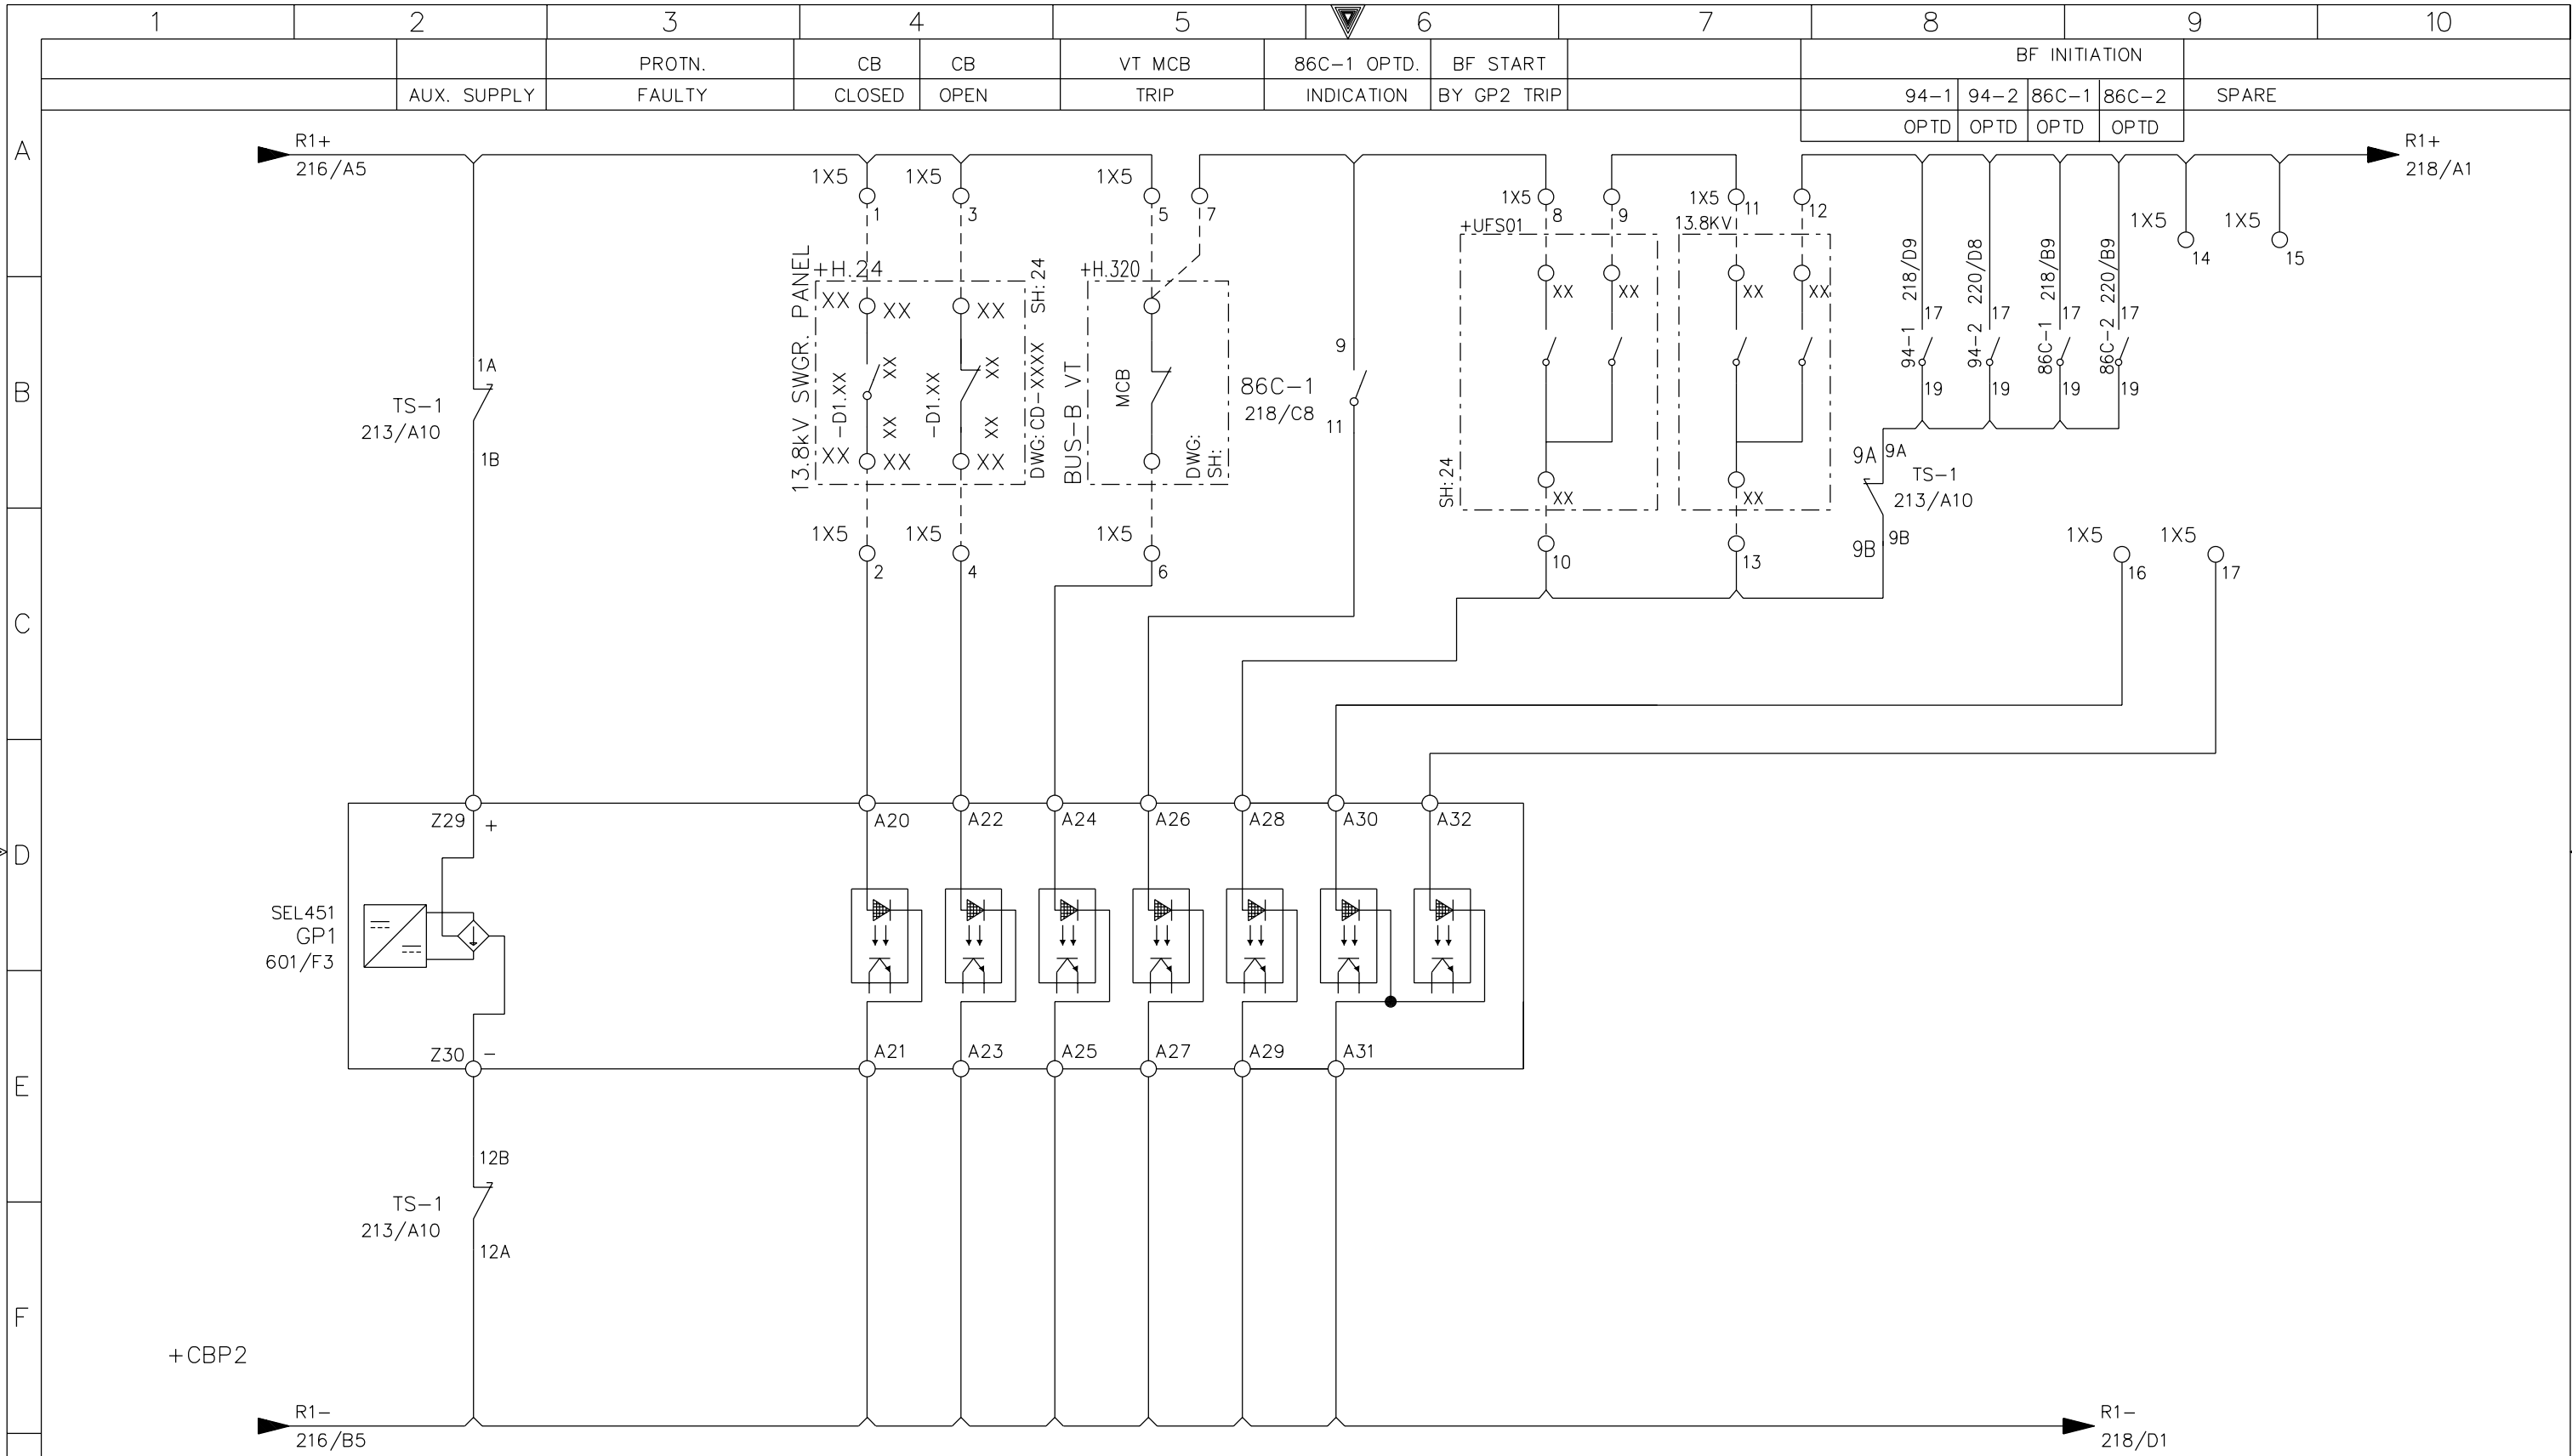


G	AS-BUILT BY _____ DATE _____		CONTRACT NO. 11131113/00		JOB ORDER NO. S-13656		DC LOGIC CIRCUITS-GP1 PROTECTION		<div>الشركة الوطنية لنقل الكهرباء</div> <div>نقل الكهرباء</div> <div>National Grid SA</div>					
				DRAWN BY <u>RIZ</u> CHECKED BY <u>KVR</u>		13.8kV CAPACITOR BANK-2 PROT. PANEL								
	01	14 08	FACTORY AS BUILT		DATE STARTED <u>24.01.2013</u> DATE COMPLETED _____		S/S 8709-132/13.8KV IN AL-KHARJ CITY							
	00	13 04	FOR APPROVAL		OPRG. DEPT. <u>CTPD</u> ENG. DEPT. <u>AUT-PSAC</u>		RIYADH SAUDI ARABIA							
	REV. NO.	DATE	DESCRIPTION						INDEX	PLANT NO.	DRAWING NUMBER		SHEET NO.	
								P	C421	CD-322954		SHT	CONT.	01
												217	218	

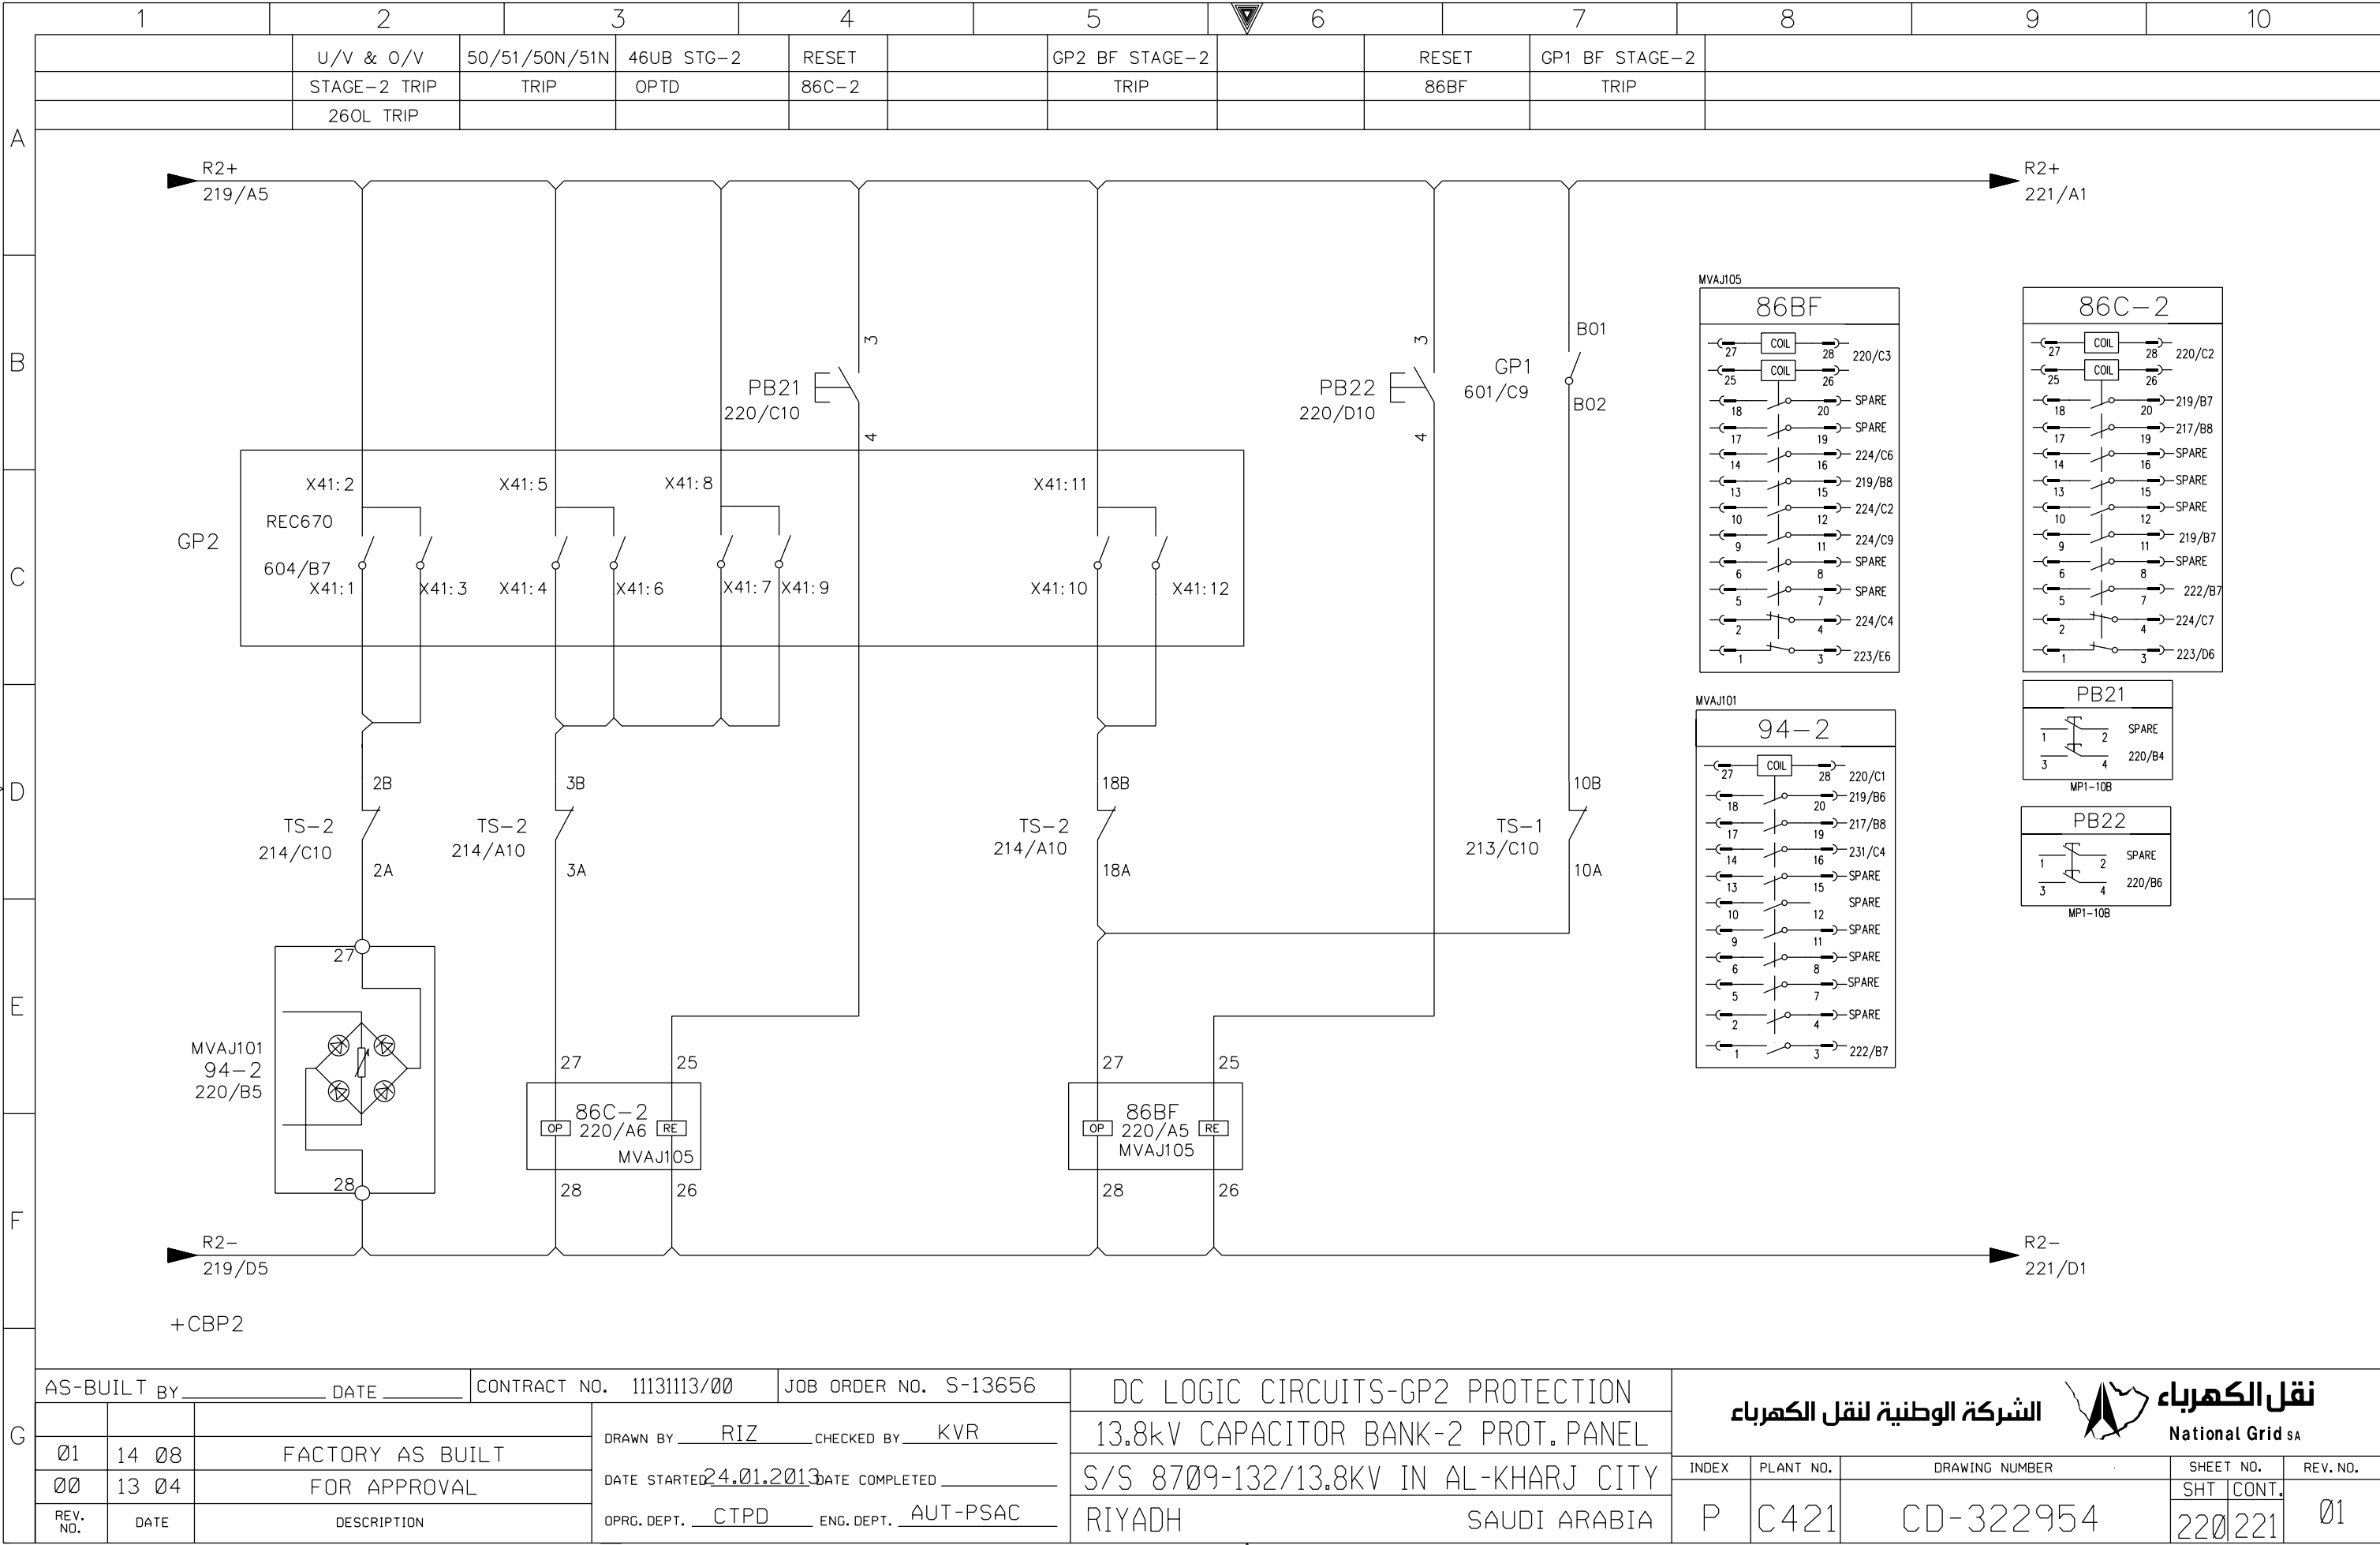

G	AS-BUILT BY _____ DATE _____		CONTRACT NO. 11131113/00		JOB ORDER NO. S-13656		DC LOGIC CIRCUITS-GP2 PROTECTION		<div><div>نقل الكهرباء</div><div>الشركة الوطنية لنقل الكهرباء</div><div>National Grid sa</div></div>					
					DRAWN BY <u> RIZ </u> CHECKED BY <u> KVR </u>		13.8kV CAPACITOR BANK-2 PROT. PANEL							
	01	14 08	FACTORY AS BUILT		DATE STARTED <u>24.01.2013</u> DATE COMPLETED _____		S/S 8709-132/13.8KV IN AL-KHARJ CITY							
	00	13 04	FOR APPROVAL		OPRG. DEPT. <u> CTPD </u> ENG. DEPT. <u> AUT-PSAC </u>		RIYADH SAUDI ARABIA							
	REV. NO.	DATE	DESCRIPTION						INDEX	PLANT NO.	DRAWING NUMBER		SHEET NO.	
								P	C421	CD-322954		SHT 220 CONT. 221		01

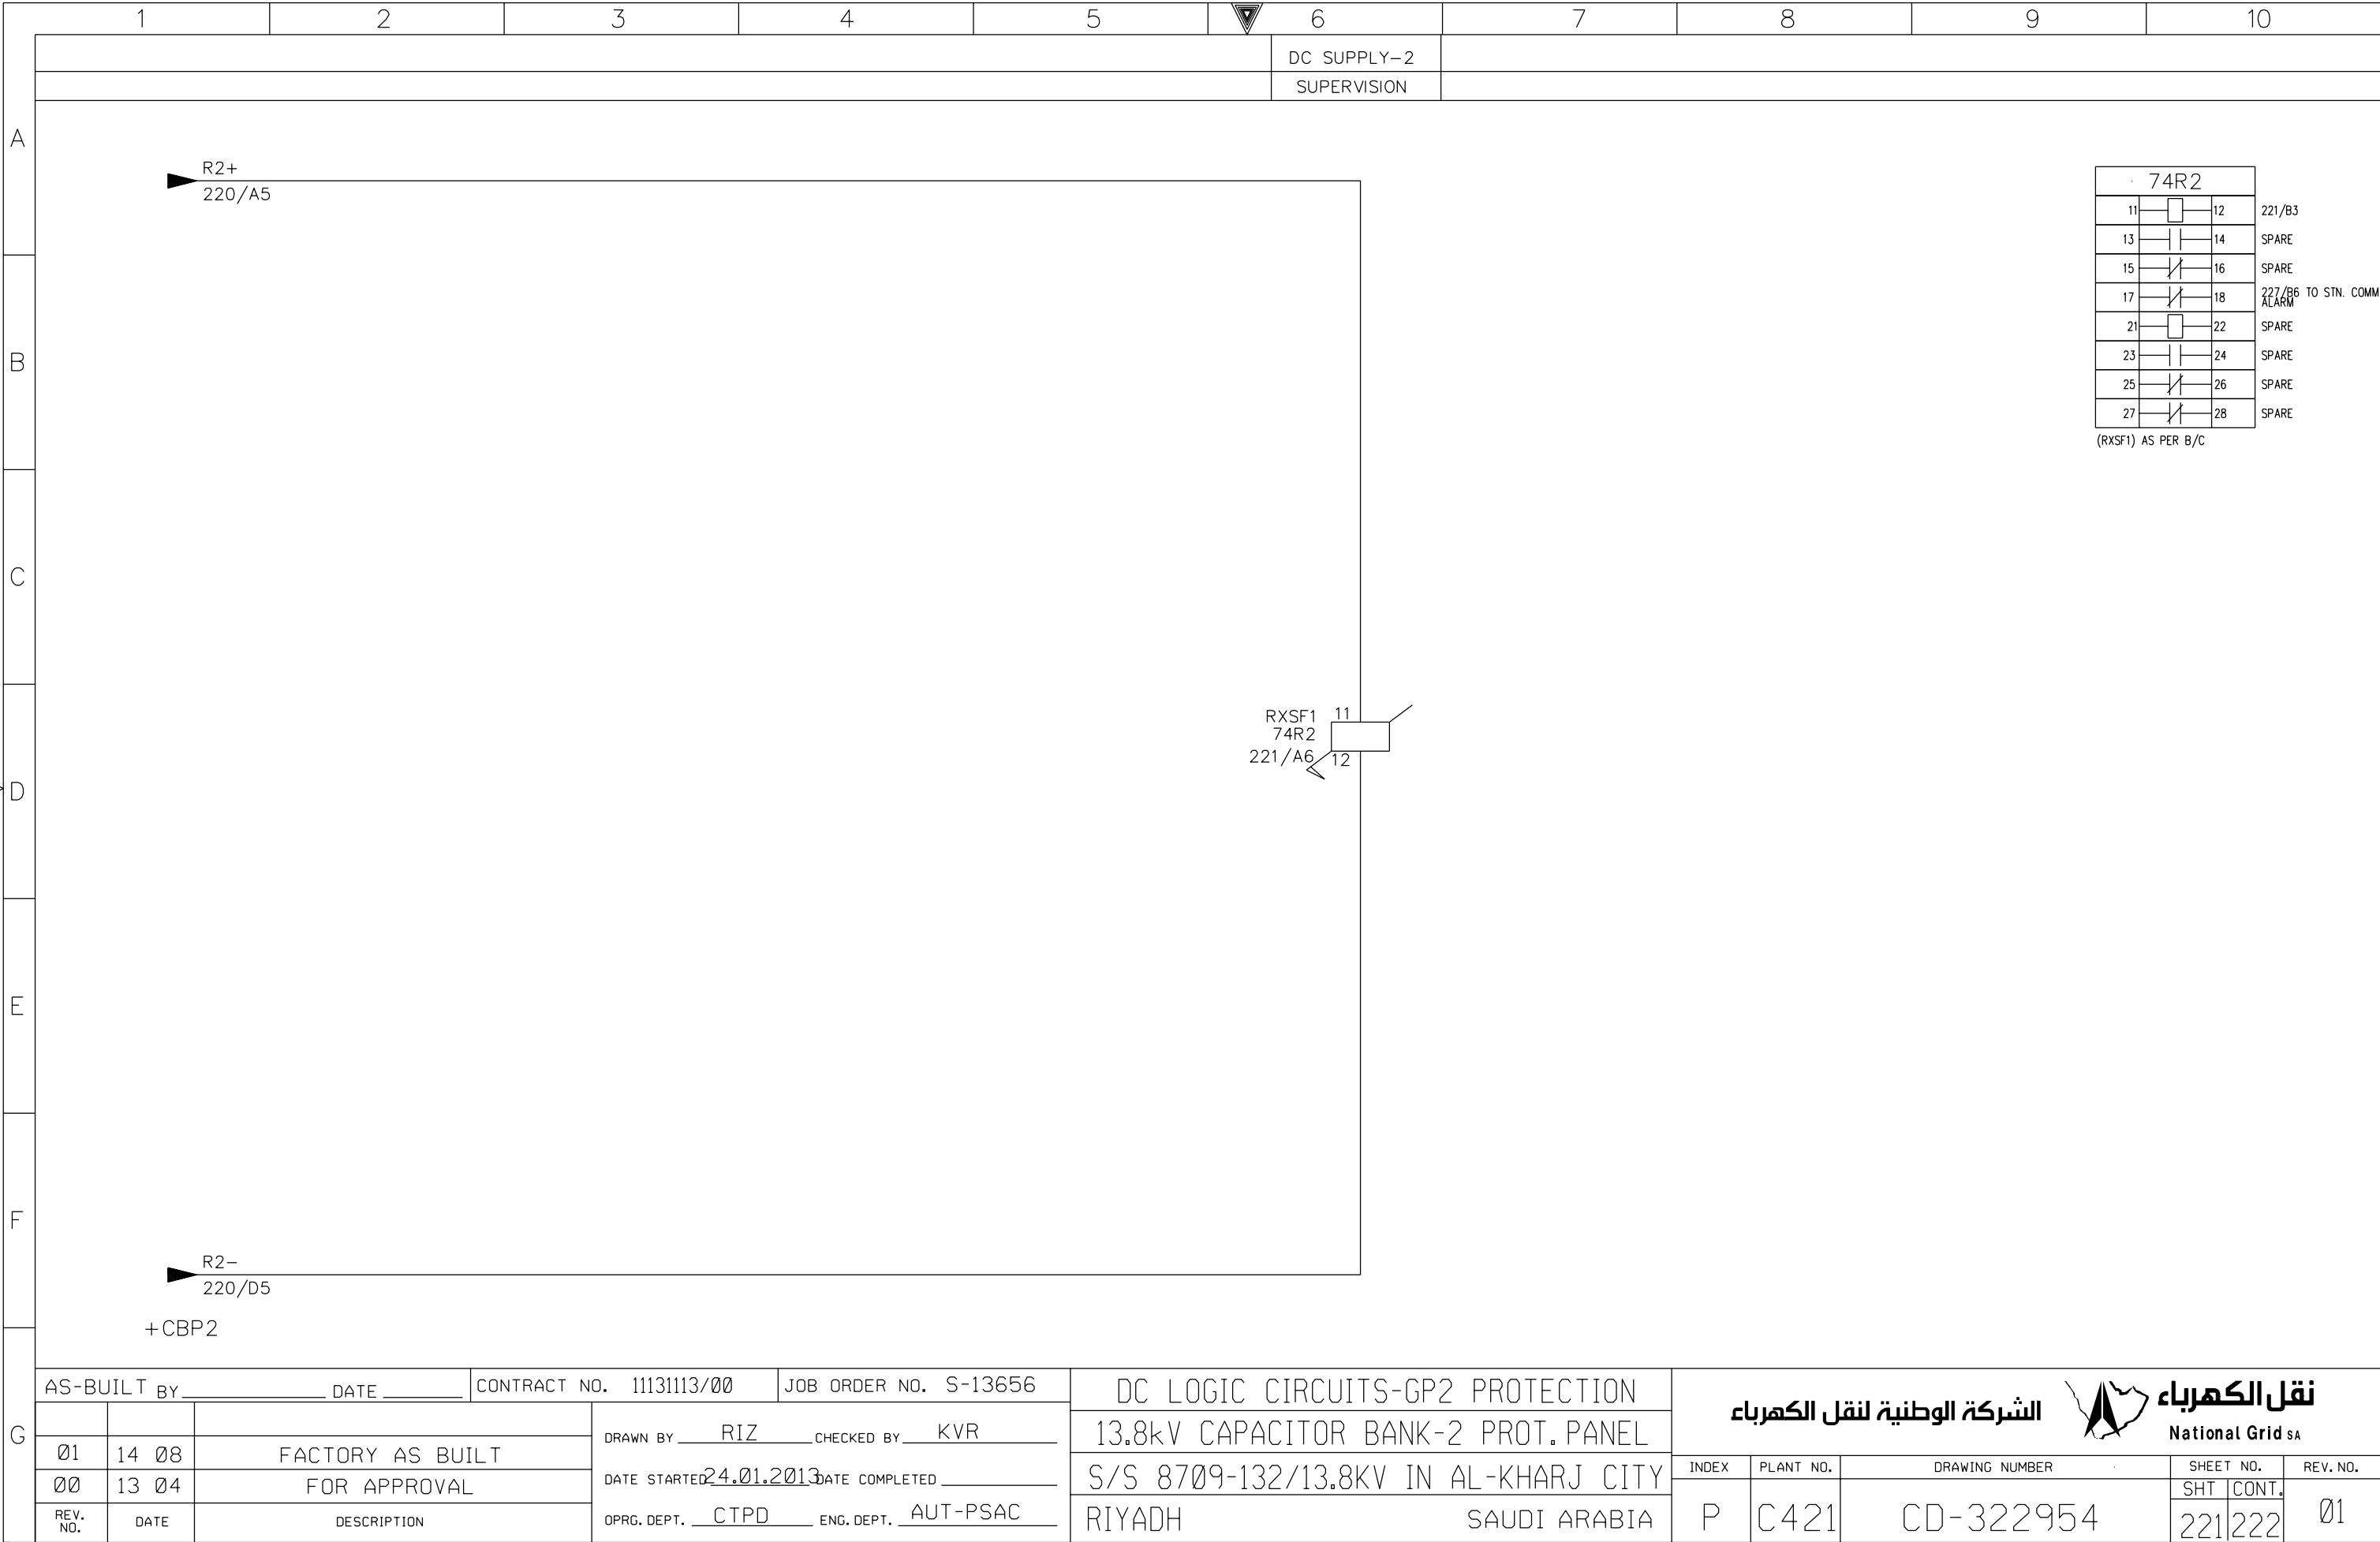

THIS DRAWING AND THE INFORMATION CONTAINED HEREIN ARE THE SOLE PROPERTY OF National Grid SA NO REPRODUCTION IN FULL OR IN PART SHALL BE OBTAINED FROM THIS DOCUMENT WITHOUT THE WRITTEN CONSENT OF ITS OWNER.

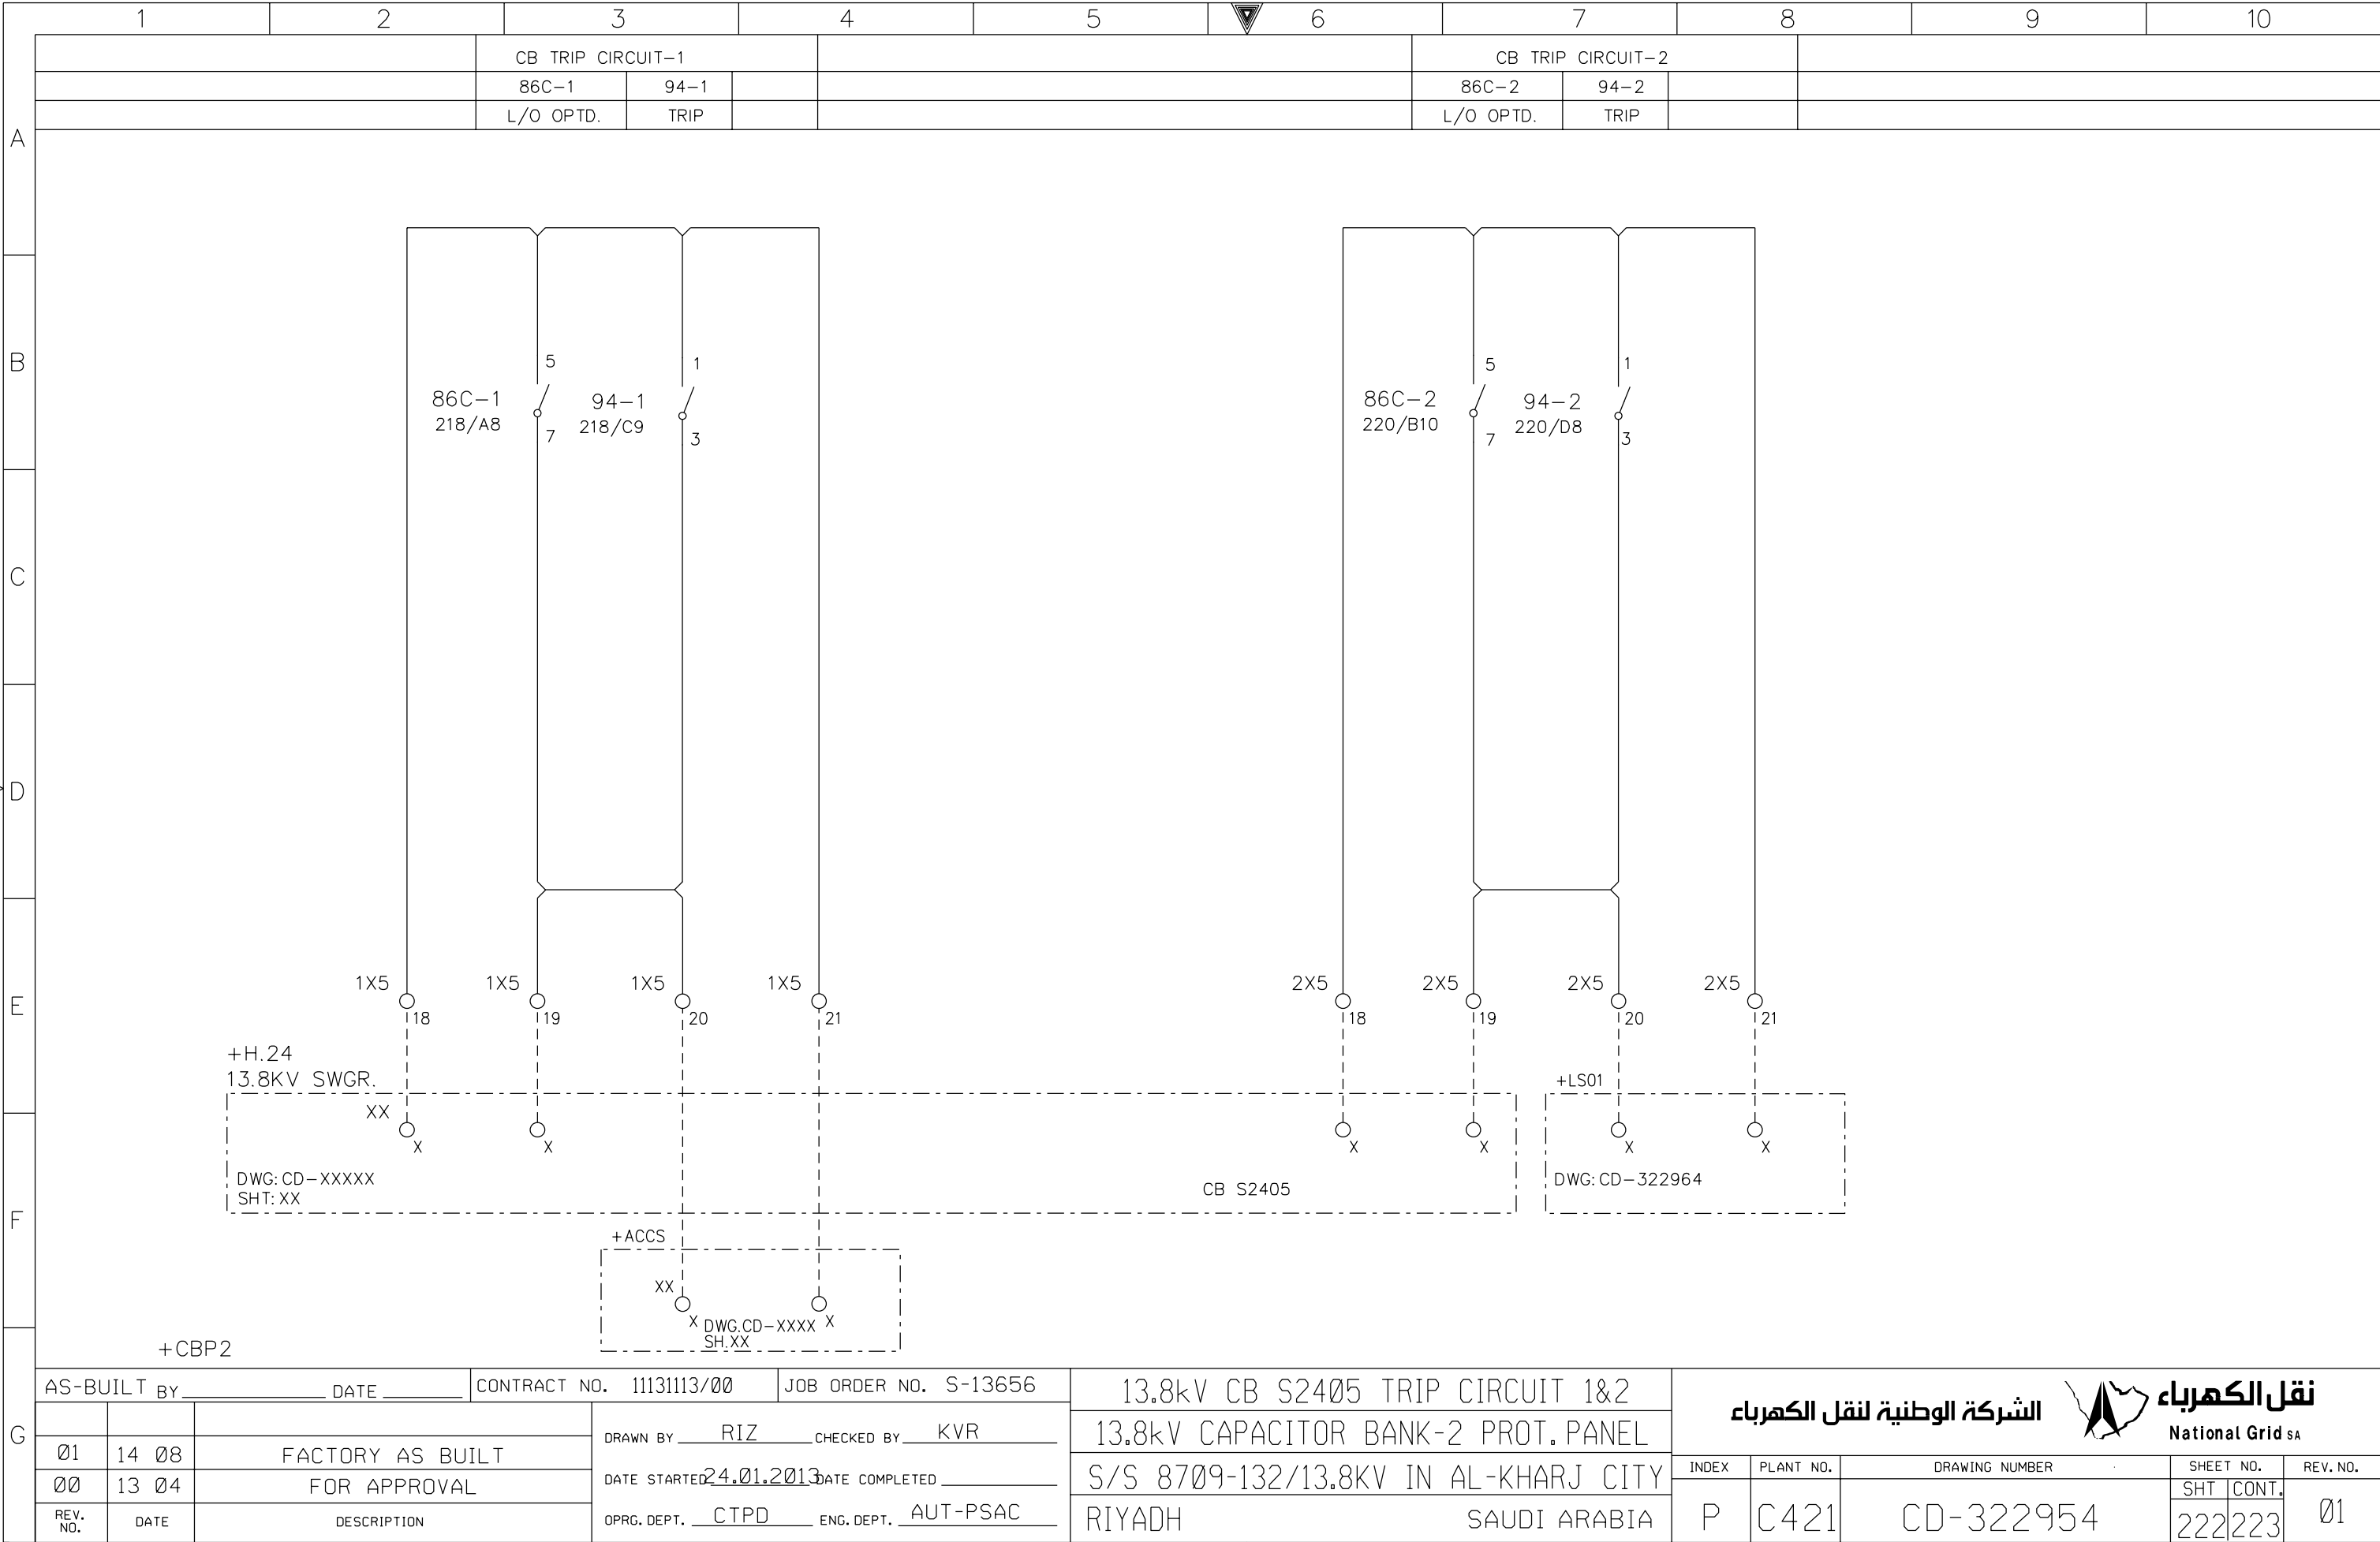

+CBP2

AS-BUILT BY _____ DATE _____

CONTRACT NO. 11131113/00

JOB ORDER NO. S-13656

01

14 08

FACTORY AS BUILT

00

13 04

FOR APPROVAL

REV. NO.

DATE

DESCRIPTION

DRAWN BY RIZ

CHECKED BY KVR

DATE STARTED 24.01.2013

DATE COMPLETED

OPRG. DEPT. CTPD

ENG. DEPT. AUT-PSAC

13.8kv CB S2405 TRIP CIRCUIT 1&2

13.8kv CAPACITOR BANK-2 PROT. PANEL

S/S 8709-132/13.8KV IN AL-KHARJ CITY

RIYADH SAUDI ARABIA

الشركة الوطنية لنقل الكهرباء

National Grid sa

INDEX

PLANT NO.

DRAWING NUMBER

SHEET NO.

REV. NO.

P

C421

CD-322954

222

223

01



THIS DRAWING AND THE INFORMATION CONTAINED HEREIN ARE THE SOLE PROPERTY OF National Grid SA NO REPRODUCTION IN FULL OR IN PART SHALL BE OBTAINED FROM THIS DOCUMENT WITHOUT THE WRITTEN CONSENT OF ITS OWNER.




نقل الكهرباء
National Grid sa


DMS

VECTOR


NGD200

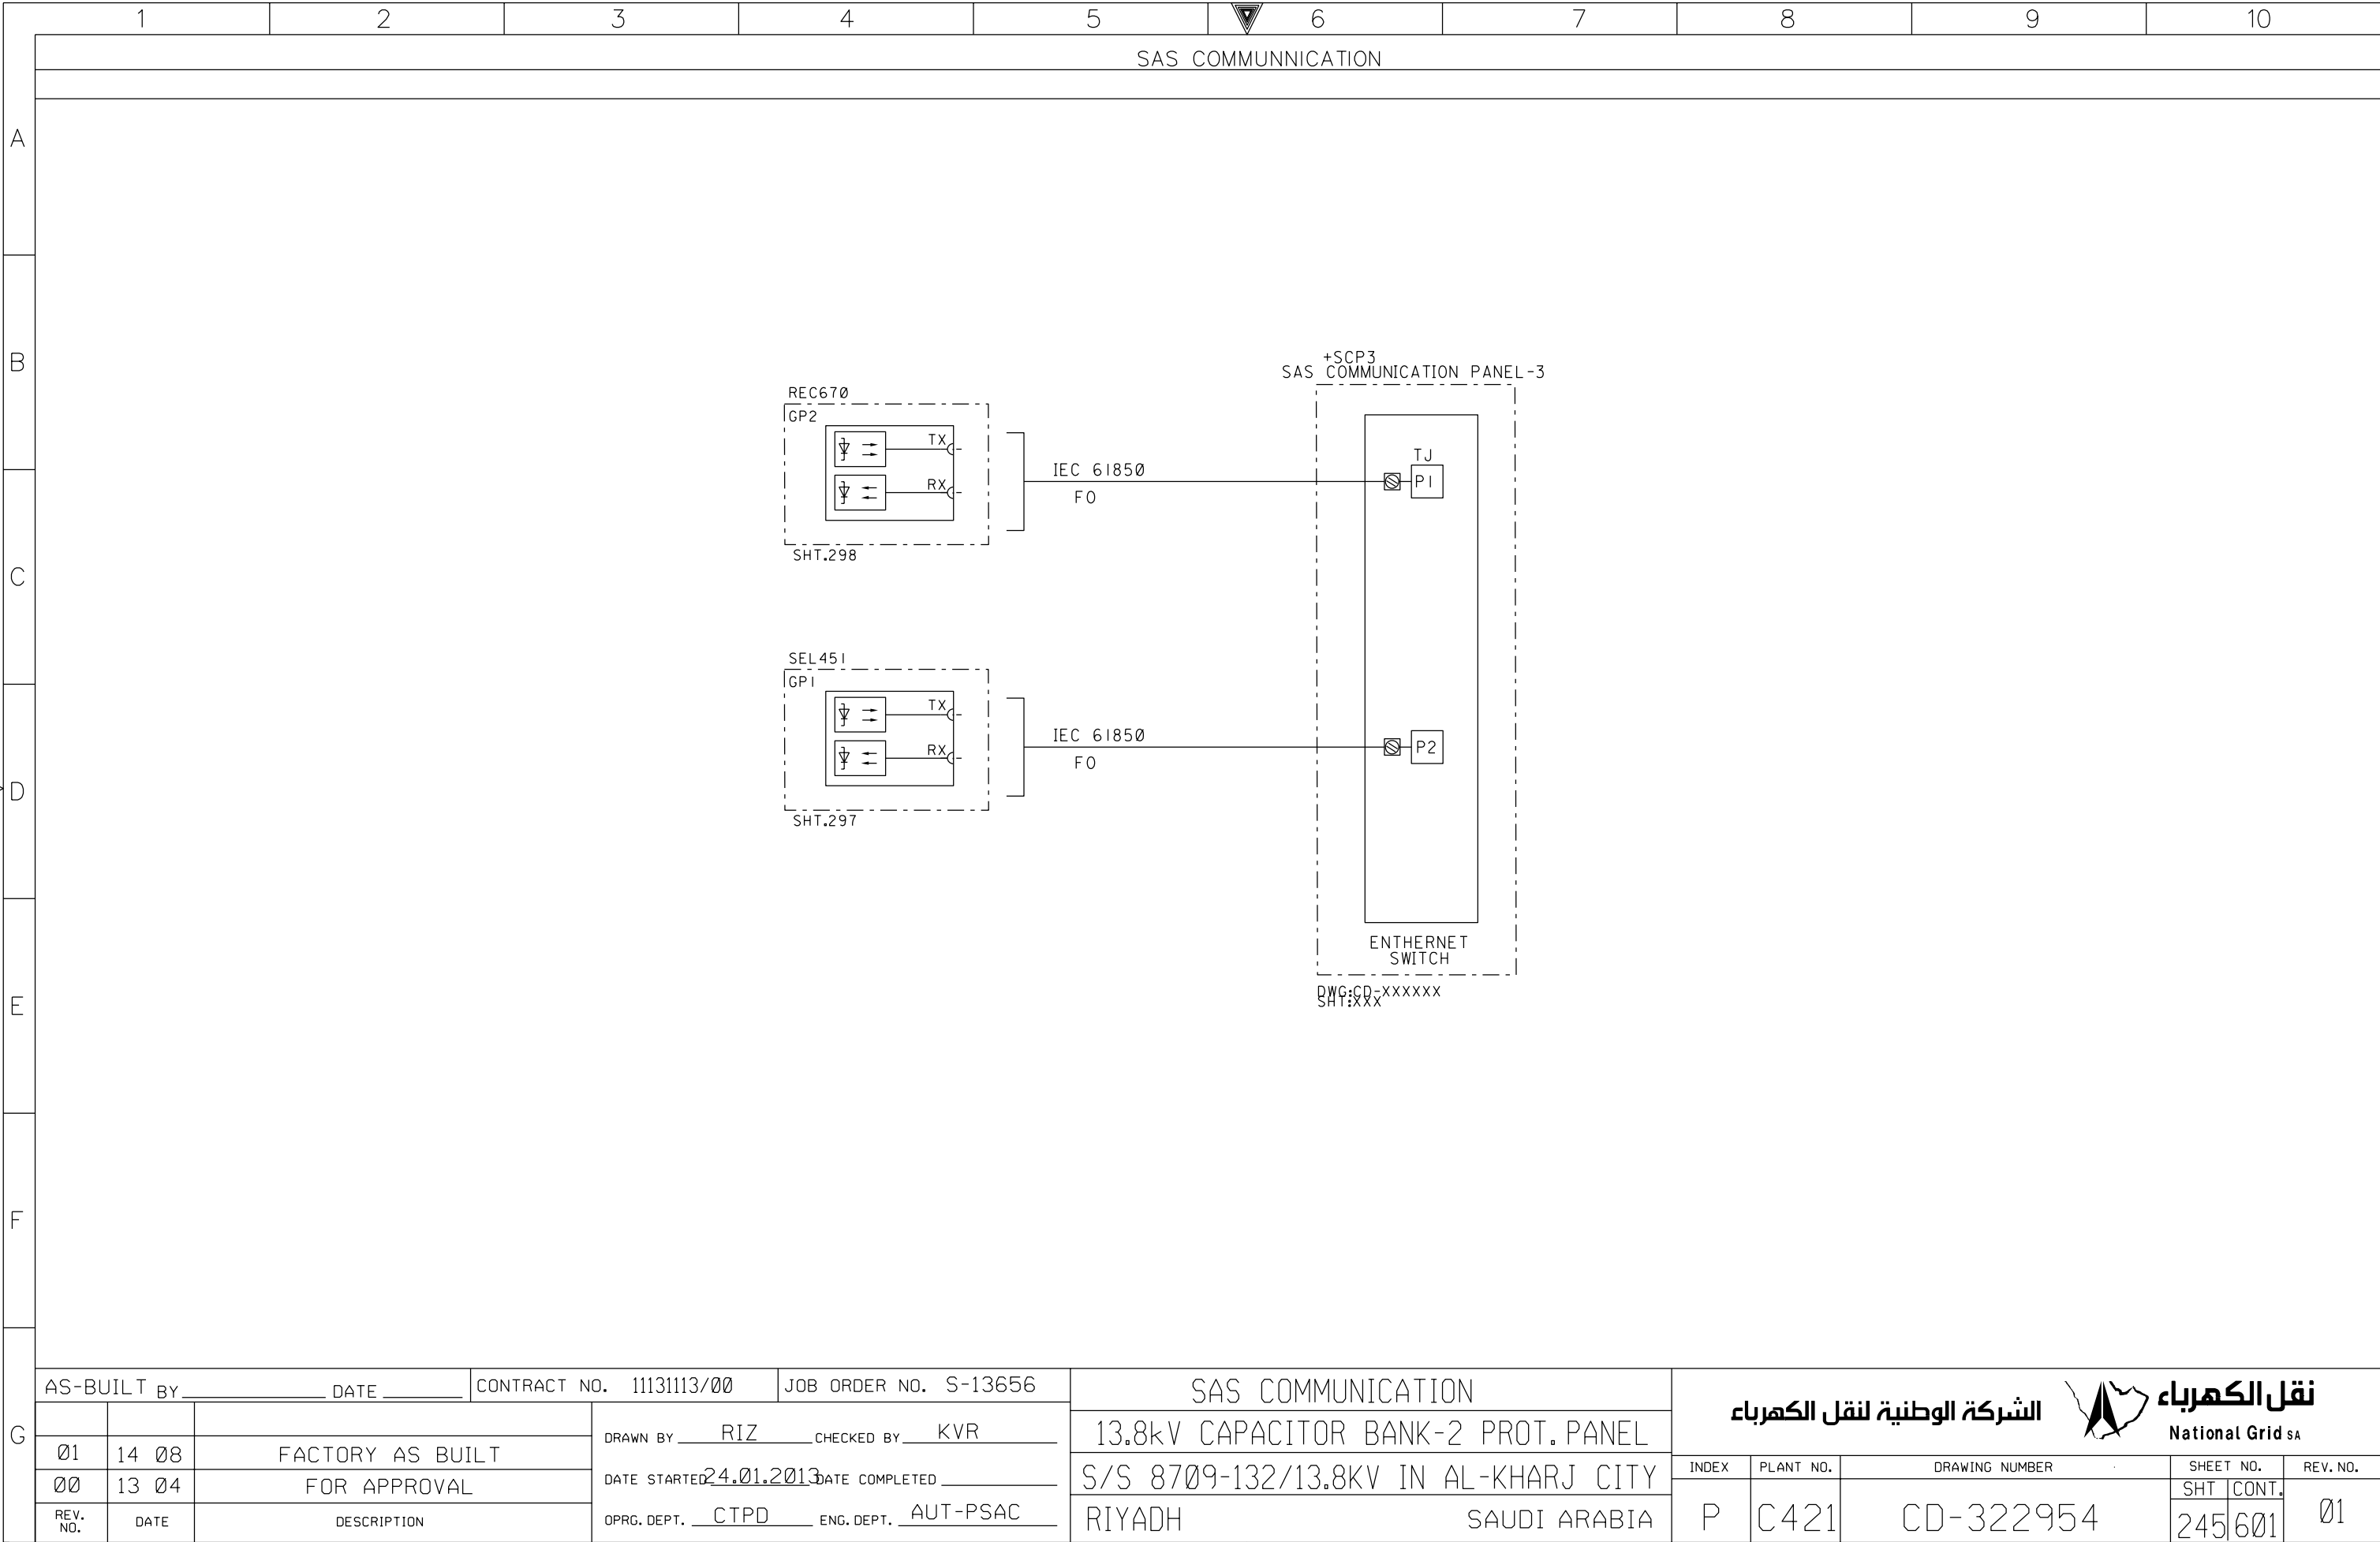


NG/D2-D (2012/01)

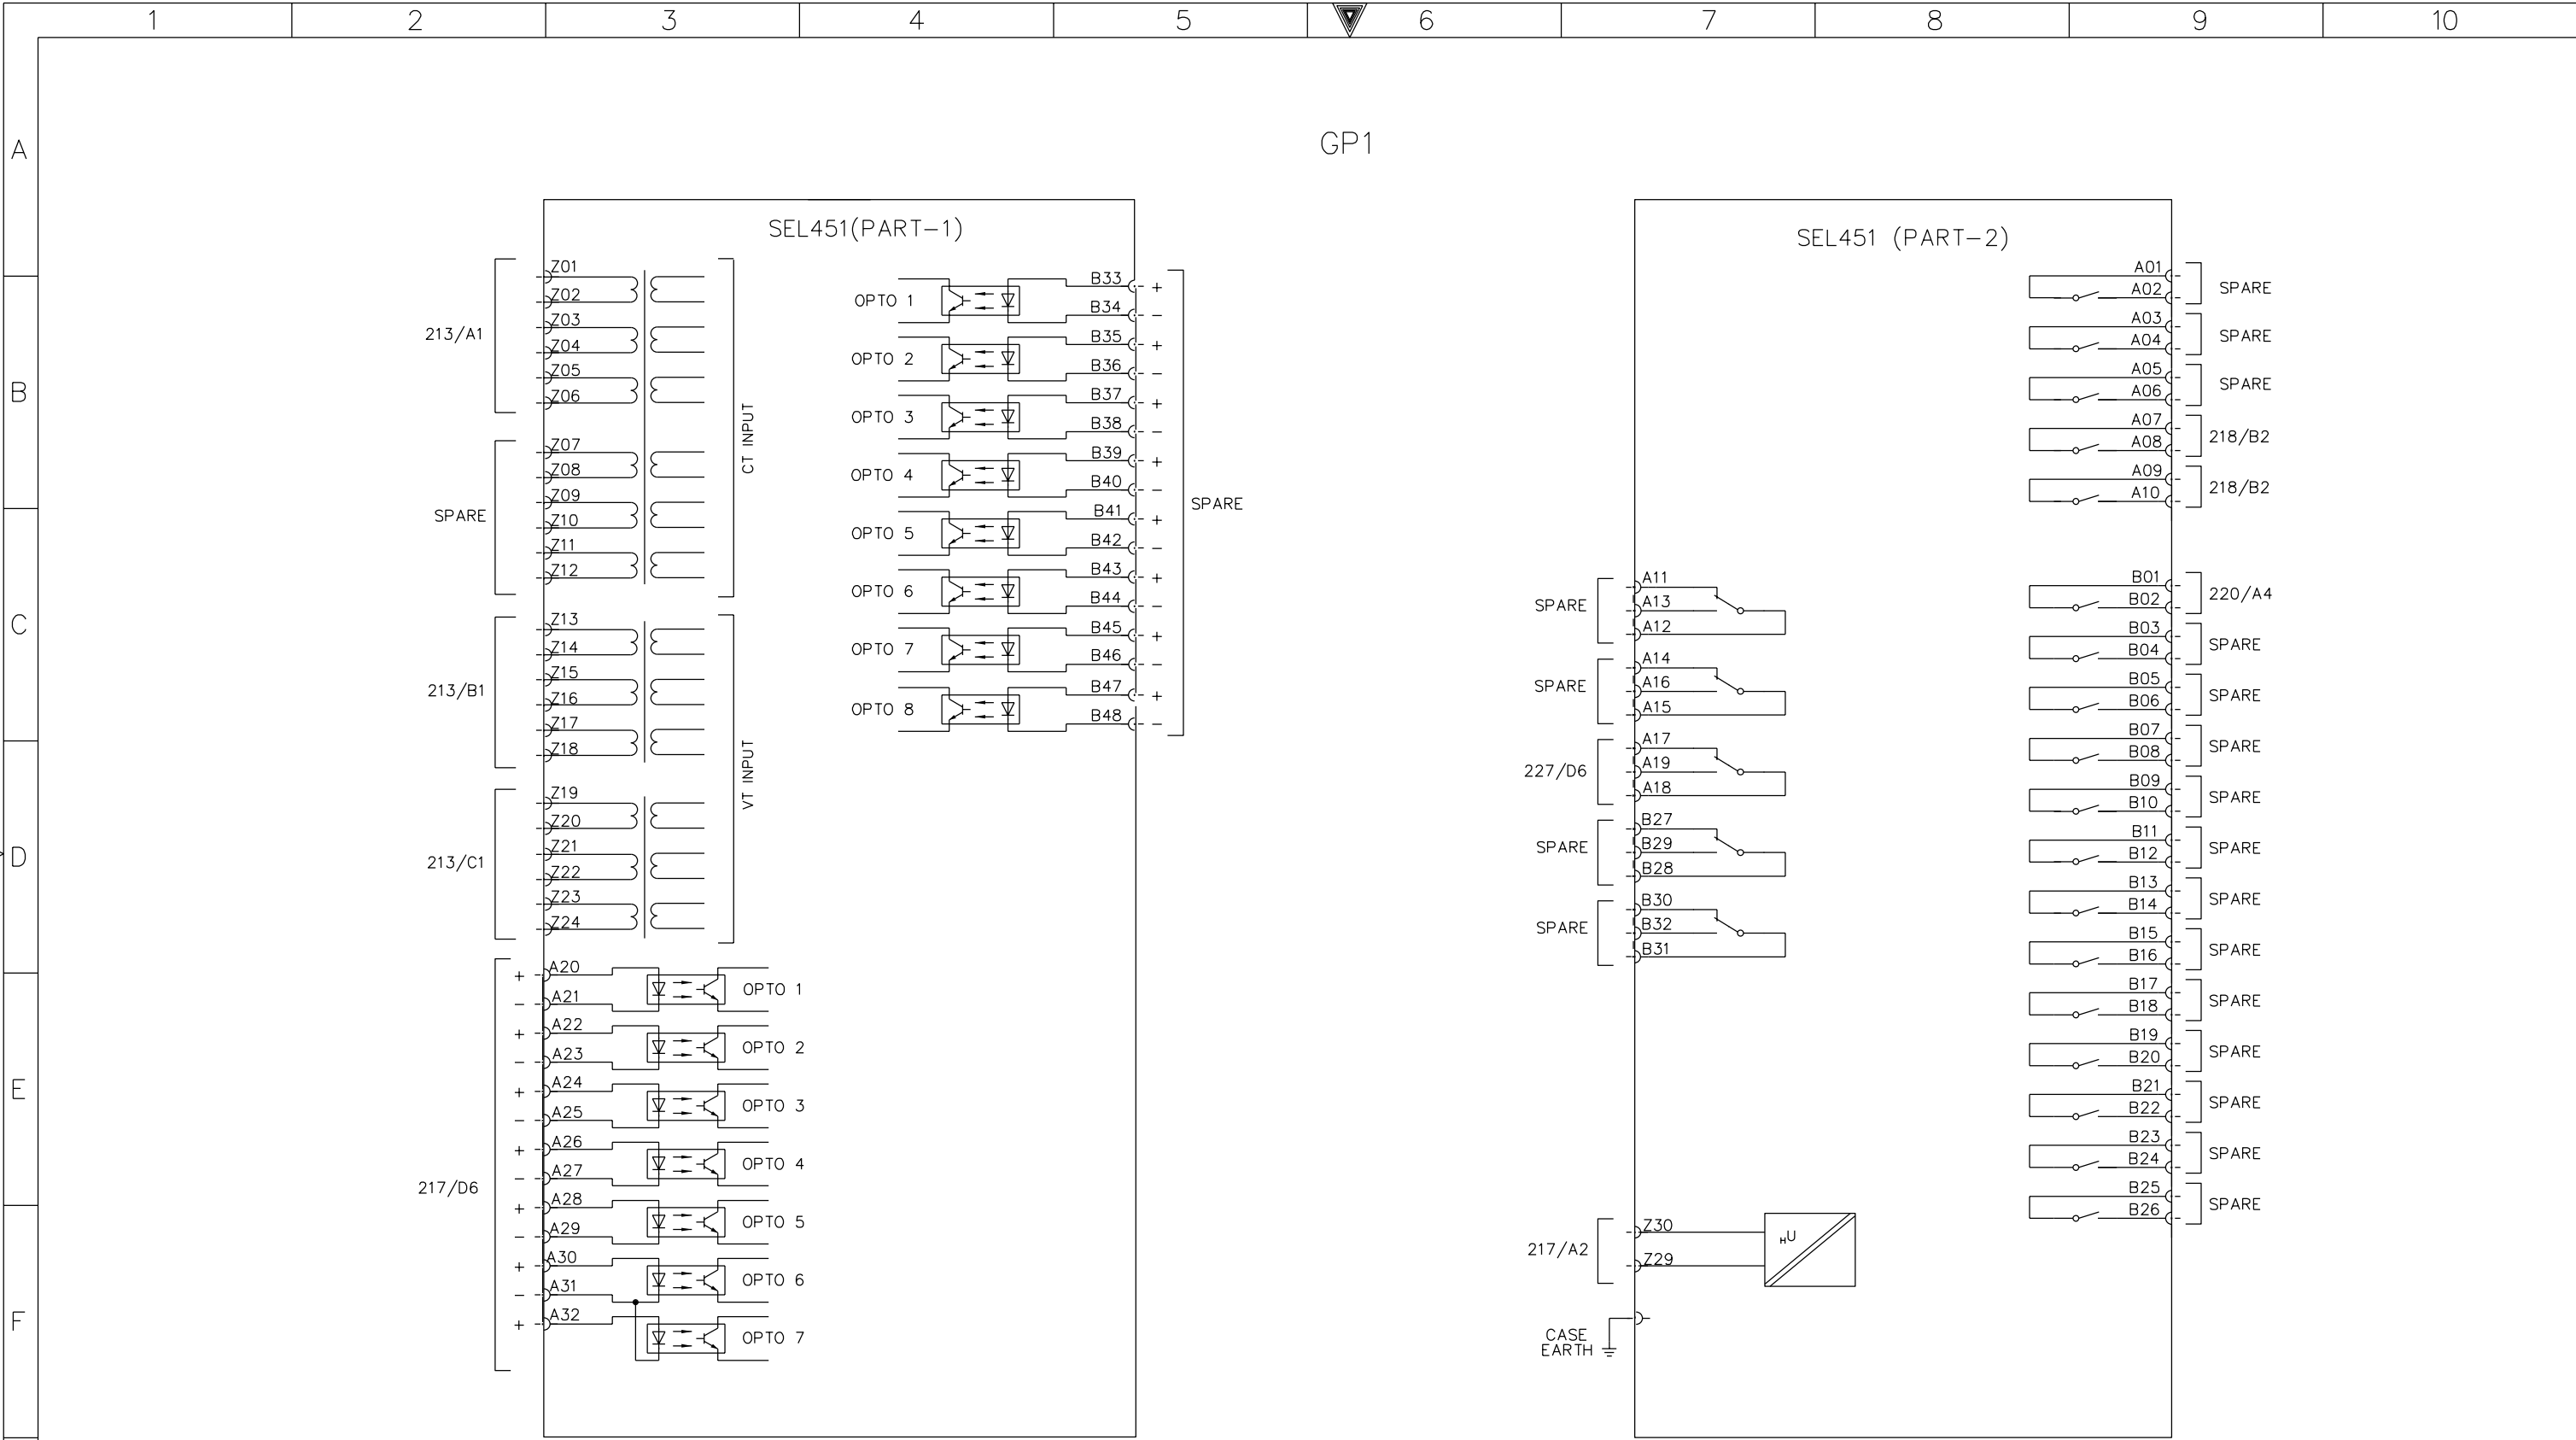

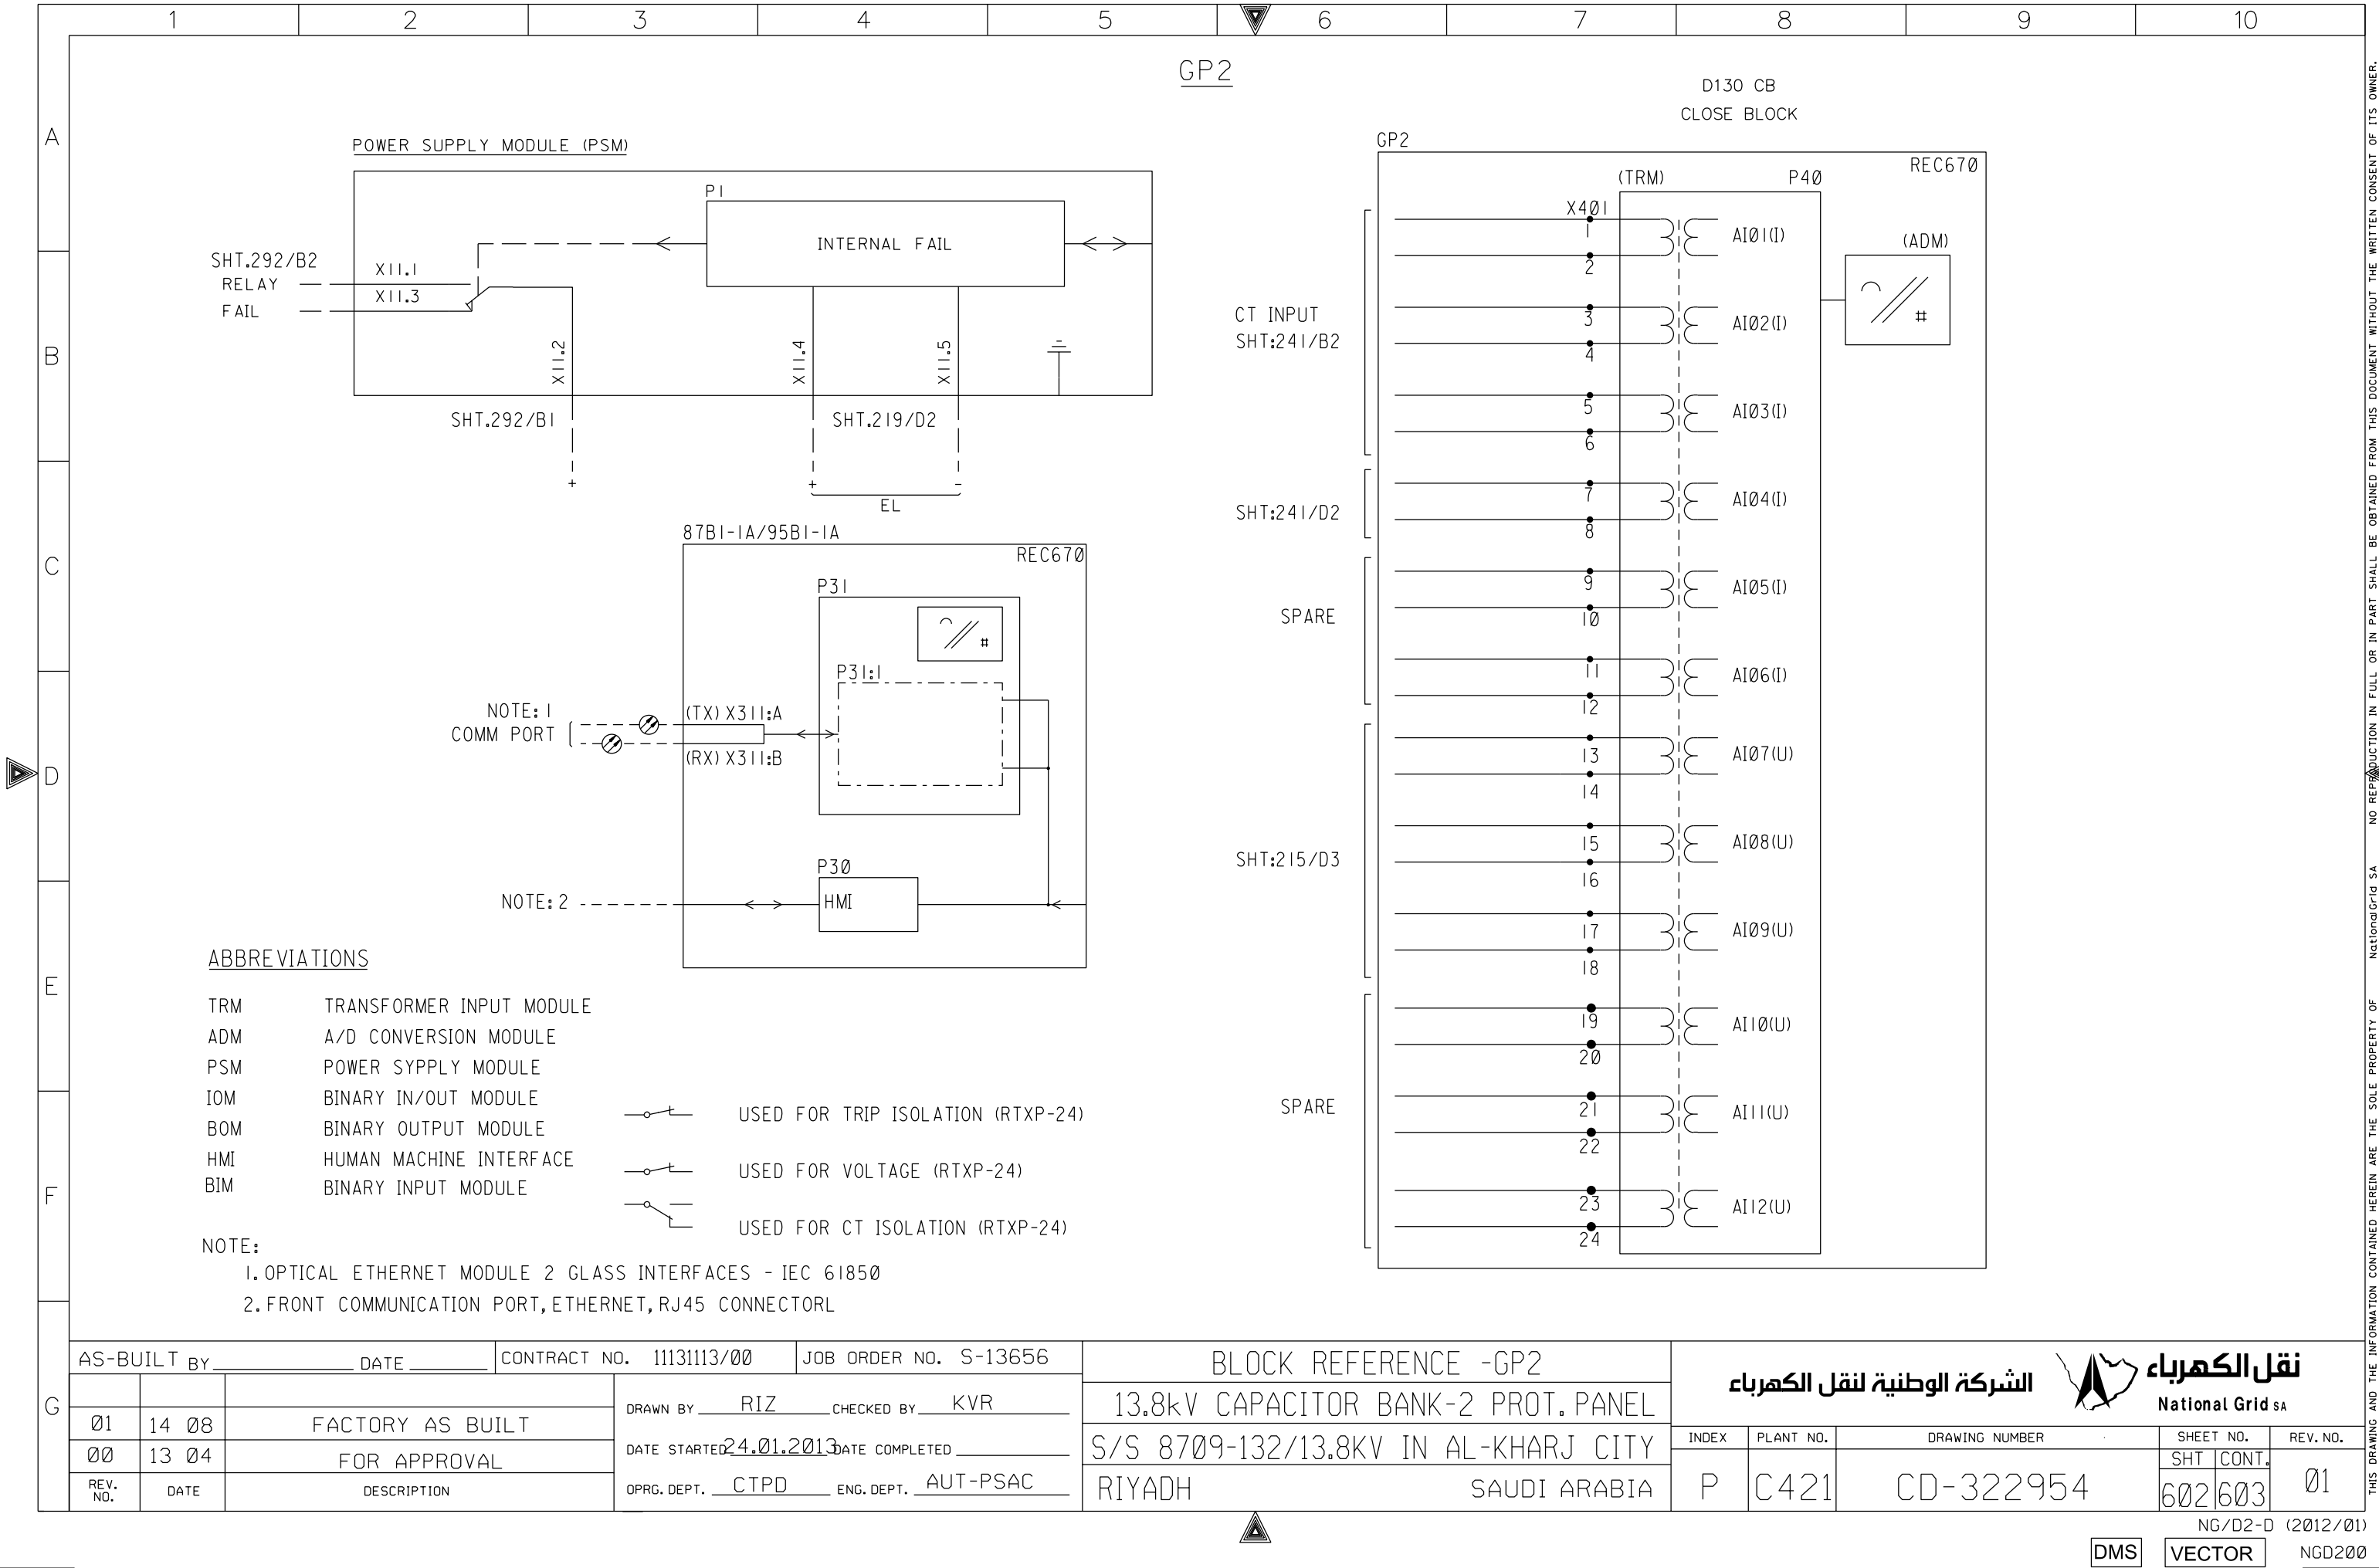

G	AS-BUILT BY _____ DATE _____		CONTRACT NO. 11131113/00		JOB ORDER NO. S-13656		BLOCK REFERENCE-GP1		<div>نقل الكهرباء</div> <div>الشركة الوطنية لنقل الكهرباء</div> <div>National Grid sa</div>						
					DRAWN BY <u> RIZ </u> CHECKED BY <u> KVR </u>		13.8kV CAPACITOR BANK-2 PROT. PANEL								
	01	14 08	FACTORY AS BUILT		DATE STARTED <u>24.01.2013</u> DATE COMPLETED _____		S/S 8709-132/13.8KV IN AL-KHARJ CITY								
	00	13 04	FOR APPROVAL		OPRG. DEPT. <u> CTPD </u> ENG. DEPT. <u> AUT-PSAC </u>		RIYADH SAUDI ARABIA		INDEX	PLANT NO.	DRAWING NUMBER		SHEET NO.		REV. NO.
	REV. NO.	DATE	DESCRIPTION						P	C421	CD-322954		SHT	CONT.	01



	1	2	3	4	5	6	7	8	9	10																																																																																																																																																																																																																																																																																																																		
A	GP2																																																																																																																																																																																																																																																																																																																											
B	BINARY INPUT CARD																																																																																																																																																																																																																																																																																																																											
C	<div><div>GP2</div><div>BIM P3 REC670</div><div><div>LOCATION=P3 PLANT ADAPTED CONFIGURATION</div><table><tr><td>SHT.219/D4</td><td>{</td><td>+</td><td>---</td><td>X31</td><td></td><td>BI.01</td><td>//</td><td>CB CLOSED</td></tr><tr><td></td><td></td><td>-</td><td>---</td><td>1</td><td></td><td></td><td></td><td></td></tr><tr><td>SHT.219/D4</td><td>{</td><td>+</td><td>---</td><td>2</td><td></td><td>BI.02</td><td>//</td><td>CB OPEN</td></tr><tr><td></td><td></td><td>-</td><td>---</td><td>3</td><td></td><td></td><td></td><td></td></tr><tr><td>SHT.219/D5</td><td>{</td><td>+</td><td>---</td><td>4</td><td></td><td>BI.03</td><td>//</td><td>BF START BY GPI</td></tr><tr><td></td><td></td><td>-</td><td>---</td><td>5</td><td></td><td></td><td></td><td></td></tr><tr><td>SHT.219/D5</td><td>{</td><td>+</td><td>---</td><td>6</td><td></td><td>BI.04</td><td>//</td><td>VT MCB TRIP</td></tr><tr><td></td><td></td><td>-</td><td>---</td><td>7</td><td></td><td></td><td></td><td></td></tr><tr><td>SHT.219/D6</td><td>{</td><td>+</ttd>SPARE</td></tr><tr><td></td><td></td><td>-</td><td>---</td><td>16</td><td></td><td></td><td></td><td></td></tr></table></div></div>										SHT.219/D4	{	+	---	X31		BI.01	//	CB CLOSED			-	---	1					SHT.219/D4	{	+	---	2		BI.02	//	CB OPEN			-	---	3					SHT.219/D5	{	+	---	4		BI.03	//	BF START BY GPI			-	---	5					SHT.219/D5	{	+	---	6		BI.04	//	VT MCB TRIP			-	---	7					SHT.219/D6	{	+	---	8		BI.05	//	86C-2 OPTD			-	---	9					SHT.219/D6	{	+	---	10		BI.06	//	86BF OPTD			-	---	11					SHT.219/D7	{	+	---	12		BI.07	//	SPARE			-	---	13					SHT.219/D7	{	+	---	14		BI.08	//	SPARE			-	---	15									16									X32							+	---	1		BI.09	//	SPARE			-	---	2							+	---	3		BI.10	//	SPARE			-	---	4							+	---	5		BI.11	//	SPARE			-	---	6							+	---	7		BI.12	//	SPARE			-	---	8							+	---	9		BI.13	//	SPARE			-	---	10							+	---	11		BI.14	//	SPARE			-	---	12							+	---	13		BI.15	//	SPARE			-	---	14							+	---	15		BI.16	//	SPARE			-	---	16				
SHT.219/D4	{	+	---	X31		BI.01	//	CB CLOSED																																																																																																																																																																																																																																																																																																																				
		-	---	1																																																																																																																																																																																																																																																																																																																								
SHT.219/D4	{	+	---	2		BI.02	//	CB OPEN																																																																																																																																																																																																																																																																																																																				
		-	---	3																																																																																																																																																																																																																																																																																																																								
SHT.219/D5	{	+	---	4		BI.03	//	BF START BY GPI																																																																																																																																																																																																																																																																																																																				
		-	---	5																																																																																																																																																																																																																																																																																																																								
SHT.219/D5	{	+	---	6		BI.04	//	VT MCB TRIP																																																																																																																																																																																																																																																																																																																				
		-	---	7																																																																																																																																																																																																																																																																																																																								
SHT.219/D6	{	+	---	8		BI.05	//	86C-2 OPTD																																																																																																																																																																																																																																																																																																																				
		-	---	9																																																																																																																																																																																																																																																																																																																								
SHT.219/D6	{	+	---	10		BI.06	//	86BF OPTD																																																																																																																																																																																																																																																																																																																				
		-	---	11																																																																																																																																																																																																																																																																																																																								
SHT.219/D7	{	+	---	12		BI.07	//	SPARE																																																																																																																																																																																																																																																																																																																				
		-	---	13																																																																																																																																																																																																																																																																																																																								
SHT.219/D7	{	+	---	14		BI.08	//	SPARE																																																																																																																																																																																																																																																																																																																				
		-	---	15																																																																																																																																																																																																																																																																																																																								
				16																																																																																																																																																																																																																																																																																																																								
				X32																																																																																																																																																																																																																																																																																																																								
		+	---	1		BI.09	//	SPARE																																																																																																																																																																																																																																																																																																																				
		-	---	2																																																																																																																																																																																																																																																																																																																								
		+	---	3		BI.10	//	SPARE																																																																																																																																																																																																																																																																																																																				
		-	---	4																																																																																																																																																																																																																																																																																																																								
		+	---	5		BI.11	//	SPARE																																																																																																																																																																																																																																																																																																																				
		-	---	6																																																																																																																																																																																																																																																																																																																								
		+	---	7		BI.12	//	SPARE																																																																																																																																																																																																																																																																																																																				
		-	---	8																																																																																																																																																																																																																																																																																																																								
		+	---	9		BI.13	//	SPARE																																																																																																																																																																																																																																																																																																																				
		-	---	10																																																																																																																																																																																																																																																																																																																								
		+	---	11		BI.14	//	SPARE																																																																																																																																																																																																																																																																																																																				
		-	---	12																																																																																																																																																																																																																																																																																																																								
		+	---	13		BI.15	//	SPARE																																																																																																																																																																																																																																																																																																																				
		-	---	14																																																																																																																																																																																																																																																																																																																								
		+	---	15		BI.16	//	SPARE																																																																																																																																																																																																																																																																																																																				
		-	---	16																																																																																																																																																																																																																																																																																																																								
D																																																																																																																																																																																																																																																																																																																												
E																																																																																																																																																																																																																																																																																																																												
F																																																																																																																																																																																																																																																																																																																												
G	<table><tr><td colspan="3">AS-BUILT BY _____ DATE _____</td><td colspan="2">CONTRACT NO. 11131113/00</td><td colspan="2">JOB ORDER NO. S-13656</td><td colspan="2">BLOCK REFERENCE -GP2</td><td colspan="2"><div>الشركة الوطنية لنقل الكهرباء</div><div> نقل الكهرباء National Grid sa</div></td></tr><tr><td></td><td></td><td></td><td colspan="2">DRAWN BY <u>RIZ</u> CHECKED BY <u>KVR</u></td><td colspan="2"></td><td colspan="2">13.8kV CAPACITOR BANK-2 PROT. PANEL</td><td colspan="2">INDEX PLANT NO. DRAWING NUMBER SHEET NO. REV. NO.</td></tr><tr><td></td><td>01</td><td>14 08</td><td colspan="2">FACTORY AS BUILT</td><td colspan="2">DATE STARTED <u>24.01.2013</u> DATE COMPLETED _____</td><td colspan="2">S/S 8709-132/13.8KV IN AL-KHARJ CITY</td><td colspan="2">P C421 CD-322954 603604 01</td></tr><tr><td></td><td>00</td><td>13 04</td><td colspan="2">FOR APPROVAL</td><td colspan="2">OPRG. DEPT. <u>CTPD</u> ENG. DEPT. <u>AUT-PSAC</u></td><td colspan="2">RIYADH SAUDI ARABIA</td><td colspan="2"></td></tr><tr><td></td><td>REV. NO.</td><td>DATE</td><td colspan="2">DESCRIPTION</td><td colspan="2"></td><td colspan="2"></td><td colspan="2"></td></tr></table>										AS-BUILT BY _____ DATE _____			CONTRACT NO. 11131113/00		JOB ORDER NO. S-13656		BLOCK REFERENCE -GP2		<div>الشركة الوطنية لنقل الكهرباء</div> <div> نقل الكهرباء National Grid sa</div>					DRAWN BY <u>RIZ</u> CHECKED BY <u>KVR</u>				13.8kV CAPACITOR BANK-2 PROT. PANEL		INDEX PLANT NO. DRAWING NUMBER SHEET NO. REV. NO.			01	14 08	FACTORY AS BUILT		DATE STARTED <u>24.01.2013</u> DATE COMPLETED _____		S/S 8709-132/13.8KV IN AL-KHARJ CITY		P C421 CD-322954 603604 01			00	13 04	FOR APPROVAL		OPRG. DEPT. <u>CTPD</u> ENG. DEPT. <u>AUT-PSAC</u>		RIYADH SAUDI ARABIA					REV. NO.	DATE	DESCRIPTION																																																																																																																																																																																																																																																																		
AS-BUILT BY _____ DATE _____			CONTRACT NO. 11131113/00		JOB ORDER NO. S-13656		BLOCK REFERENCE -GP2		<div>الشركة الوطنية لنقل الكهرباء</div> <div> نقل الكهرباء National Grid sa</div>																																																																																																																																																																																																																																																																																																																			
			DRAWN BY <u>RIZ</u> CHECKED BY <u>KVR</u>				13.8kV CAPACITOR BANK-2 PROT. PANEL		INDEX PLANT NO. DRAWING NUMBER SHEET NO. REV. NO.																																																																																																																																																																																																																																																																																																																			
	01	14 08	FACTORY AS BUILT		DATE STARTED <u>24.01.2013</u> DATE COMPLETED _____		S/S 8709-132/13.8KV IN AL-KHARJ CITY		P C421 CD-322954 603604 01																																																																																																																																																																																																																																																																																																																			
	00	13 04	FOR APPROVAL		OPRG. DEPT. <u>CTPD</u> ENG. DEPT. <u>AUT-PSAC</u>		RIYADH SAUDI ARABIA																																																																																																																																																																																																																																																																																																																					
	REV. NO.	DATE	DESCRIPTION																																																																																																																																																																																																																																																																																																																									

THIS DRAWING AND THE INFORMATION CONTAINED HEREIN ARE THE SOLE PROPERTY OF National Grid SA NO REPRODUCTION IN FULL OR IN PART SHALL BE OBTAINED FROM THIS DOCUMENT WITHOUT THE WRITTEN CONSENT OF ITS OWNER.

1		2		3		4		5		6		7		8		9		10						
A	INTERNAL REFERENCE		X3 AC CKT.		INTERNAL REFERENCE		1X1 CT CKTS.		INTERNAL REFERENCE		1X2 CT CKTS.		INTERNAL REFERENCE		1X4 DC CKTS.		INTERNAL REFERENCE		1X5 CONTROL & PROTN.		INTERNAL REFERENCE		2X5 CONTROL & PROTN.	
	211/A2		1		213/A7		1		213/D7		1		216/B3		1		217/A4		1		219/A4		1	
	211/A5		2		213/A7		2		213/E7		2		216/B3		2		217/C4		2		219/C4		2	
	211/A2		3		213/B7		3		213/E7		3		216/C3		3		217/C4		3		219/C4		3	
	211/A5		4		213/B7		4		213/E7		4		SPARE		4		217/A5		4		219/A5		4	
	211/A2		5		213/B7		5		213/F7		5		SPARE		5		217/C5		5		219/C5		5	
	211/A5		6		213/B7		6		213/F7		6		SPARE		6		217/A5		6		219/A5		6	
	211/A2		7		213/C7		7		SPARE		7		SPARE		7		217/A6		7		219/A6		7	
	211/A5		8		213/C7		8		SPARE		8		SPARE		8		217/A7		8		219/A7		8	
	SPARE		9		213/C7		9		SPARE		9		SPARE		9		217/C6		9		219/C6		9	
SPARE		10		SPARE		10		SPARE		10		SPARE		10		217/A7		10		219/A7		10		
B	INTERNAL REFERENCE		XSH SPACE HEATER		INTERNAL REFERENCE		2X1 CT CKTS.		INTERNAL REFERENCE		1X2 CT CKTS.		INTERNAL REFERENCE		2X4 DC CKTS.		INTERNAL REFERENCE		1X5 CONTROL & PROTN.		INTERNAL REFERENCE		2X5 CONTROL & PROTN.	
	211/C4		1		214/A7		1		215/C7		1		216/D3		1		222/E2		1		222/E6		1	
	211/D4		2		214/A7		2		215/C7		2		216/D3		2		222/E3		2		222/E7		2	
	SPARE		3		214/B7		3		215/D7		3		216/E3		3		222/E4		3		222/E8		3	
	INTERNAL REFERENCE		XTJ T.JACK		214/B7		4		215/D7		4		SPARE		4		222/E5		4		SPARE		4	
	211/B2		1		214/B7		5		SPARE		5		SPARE		5		223/E5		5		SPARE		5	
	211/B2		2		214/C7		6		SPARE		6		SPARE		6		223/E6		6		SPARE		6	
	211/B2		3		214/C7		7		SPARE		7		SPARE		7		SPARE		7		SPARE		7	
	211/B2		4		214/C7		8		SPARE		8		SPARE		8		SPARE		8		SPARE		8	
	SPARE		5		214/D7		9		SPARE		9		SPARE		9		SPARE		9		SPARE		9	
C	INTERNAL REFERENCE		X61 ALARM CKT		214/D7		10		INTERNAL REFERENCE		X5 CONTROL & PROTN.		INTERNAL REFERENCE		X9 SPARE CKT		INTERNAL REFERENCE		1X5 CONTROL & PROTN.		INTERNAL REFERENCE		2X5 CONTROL & PROTN.	
	216/B3		1		214/E7		11		224/D5		1		231/E3		1		217/A9		1		219/A9		1	
	216/B3		2		214/E7		12		224/D5		2		231/E3		2		222/E6		2		219/C9		2	
	227/E3		3		SPARE		13		SPARE		3		231/E4		3		222/E7		3		219/A9		3	
	227/E4		4		SPARE		14		SPARE		4		231/E4		4		222/E8		4		219/C9		4	
	227/E6		5		SPARE		15		SPARE		5		231/E5		5		SPARE		5		219/A9		5	
	227/E7		6		SPARE		16		SPARE		6		231/E5		6		SPARE		6		219/C9		6	
	SPARE		7		SPARE		17		SPARE		7		231/E6		7		SPARE		7		219/A9		7	
	SPARE		8		INTERNAL REFERENCE		X5 CONTROL & PROTN.		INTERNAL REFERENCE		X4 DC CKTS.		INTERNAL REFERENCE		X9 SPARE CKT		INTERNAL REFERENCE		1X5 CONTROL & PROTN.		INTERNAL REFERENCE		2X5 CONTROL & PROTN.	
	SPARE		9		224/D5		1		216/D3		1		217/A9		1		222/E2		1		219/A9		1	
D	SPARE		10		224/D5		2		216/D3		2		217/A9		2		222/E3		2		219/A9		2	
	SPARE		11		SPARE		3		216/E3		3		217/A9		3		222/E4		3		219/A9		3	
	SPARE		12		SPARE		4		SPARE		4		217/A9		4		222/E5		4		219/A9		4	
	SPARE		13		SPARE		5		SPARE		5		217/A9		5		222/E6		5		219/A9		5	
	SPARE		14		SPARE		6		SPARE		6		217/A9		6		222/E7		6		219/A9		6	
	SPARE		15		SPARE		7		SPARE		7		217/A9		7		222/E8		7		219/A9		7	
	SPARE		16		SPARE		8		SPARE		8		217/A9		8		SPARE		8		219/A9		8	
	SPARE		17		SPARE		9		SPARE		9		217/A9		9		SPARE		9		219/A9		9	
	SPARE		18		SPARE		10		SPARE		10		217/A9		10		SPARE		10		219/A9		10	
	SPARE		19		SPARE		11		SPARE		11		217/A9		11		SPARE		11		219/A9		11	
E	INTERNAL REFERENCE		X61 ALARM CKT		214/D7		10		INTERNAL REFERENCE		X5 CONTROL & PROTN.		INTERNAL REFERENCE		X9 SPARE CKT		INTERNAL REFERENCE		1X5 CONTROL & PROTN.		INTERNAL REFERENCE		2X5 CONTROL & PROTN.	
	216/B3		1		214/E7		11		224/D5		1		231/E3		1		217/A9		1		219/A9		1	
	216/B3		2		214/E7		12		224/D5		2		231/E3		2		222/E6		2		219/A9		2	
	227/E3		3		SPARE		13		SPARE		3		231/E4		3		222/E7		3		219/A9		3	
	227/E4		4		SPARE		14		SPARE		4		231/E4		4		222/E8		4		219/A9		4	
	227/E6		5		SPARE		15		SPARE		5		231/E5		5		SPARE		5		219/A9		5	
	227/E7		6		SPARE		16		SPARE		6		231/E5		6		SPARE		6		219/A9		6	
	SPARE		7		SPARE		17		SPARE		7		231/E6		7		SPARE		7		219/A9		7	
	SPARE		8		INTERNAL REFERENCE		X5 CONTROL & PROTN.		INTERNAL REFERENCE		X4 DC CKTS.		INTERNAL REFERENCE		X9 SPARE CKT		INTERNAL REFERENCE		1X5 CONTROL & PROTN.		INTERNAL REFERENCE		2X5 CONTROL & PROTN.	
	SPARE		9		224/D5		1		216/D3		1		217/A9		1		222/E2		1		219/A9		1	
F	SPARE		10		224/D5		2		216/D3		2		217/A9		2		222/E3		2		219/A9		2	
	SPARE		11		SPARE		3		216/E3		3		217/A9		3		222/E4		3		219/A9		3	
	SPARE		12		SPARE		4		SPARE		4		217/A9		4		222/E5		4		219/A9		4	
	SPARE		13		SPARE		5		SPARE		5		217/A9		5		222/E6		5		219/A9		5	
	SPARE		14		SPARE		6		SPARE		6		217/A9		6		222/E7		6		219/A9		6	
	SPARE		15		SPARE		7		SPARE		7		217/A9		7		222/E8		7		219/A9		7	
	SPARE		16		SPARE		8		SPARE		8		217/A9		8		SPARE		8		219/A9		8	
	SPARE		17		SPARE		9		SPARE		9		217/A9		9		SPARE		9		219/A9		9	
	SPARE		18		SPARE		10		SPARE		10		217/A9		10		SPARE		10		219/A9		10	
	SPARE		19		SPARE		11		SPARE		11		217/A9		11		SPARE		11		219/A9		11	
G	INTERNAL REFERENCE		X61 ALARM CKT		214/D7		10		INTERNAL REFERENCE		X5 CONTROL & PROTN.		INTERNAL REFERENCE		X9 SPARE CKT		INTERNAL REFERENCE		1X5 CONTROL & PROTN.		INTERNAL REFERENCE		2X5 CONTROL & PROTN.	
	216/B3		1		214/E7		11		224/D5		1		231/E3		1		217/A9		1		219/A9		1	
	216/B3		2		214/E7		12		224/D5		2		231/E3		2		222/E6		2		219/A9		2	
	227/E3		3		SPARE		13		SPARE		3		231/E4		3		222/E7		3		219/A9		3	
	227/E4		4		SPARE		14		SPARE		4		231/E4		4		222/E8		4		219/A9		4	
	227/E6		5		SPARE		15		SPARE		5		231/E5		5		SPARE		5		219/A9		5	
	227/E7		6		SPARE		16		SPARE		6		231/E5		6		SPARE		6		219/A9		6	
	SPARE		7		SPARE		17		SPARE		7		231/E6		7		SPARE		7		219/A9		7	
	SPARE		8		INTERNAL REFERENCE		X5 CONTROL & PROTN.		INTERNAL REFERENCE		X4 DC CKTS.		INTERNAL REFERENCE		X9 SPARE CKT		INTERNAL REFERENCE		1X5 CONTROL & PROTN.		INTERNAL REFERENCE		2X5 CONTROL & PROTN.	
	SPARE		9		224/D5		1		216/D3		1		217/A9		1		222/E2		1		219/A9		1	
SPARE		10		224/D5		2		216/D3		2		217/A9		2		222/E3		2		219/A9		2		
AS-BUILT BY _____ DATE _____		CONTRACT NO. 11131113/00		JOB ORDER NO. S-13656		TERMINAL BLOCK ALLOCATION		13.8kV CAPACITOR BANK-2 PROT. PANEL		الشركة الوطنية لنقل الكهرباء		National Grid sa		INDEX		PLANT NO.		DRAWING NUMBER		SHEET NO.		REV. NO.		
01 14 08		FACTORY AS BUILT		DRAWN BY RIZ CHECKED BY KVR		13.8kV CAPACITOR BANK-2 PROT. PANEL		S/S 8709-132/13.8KV IN AL-KHARJ CITY		P		C421		CD-322954		605		NIL		01				
00 13 04		FOR APPROVAL		DATE STARTED 24.01.2013 DATE COMPLETED _____		S/S 8709-132/13.8KV IN AL-KHARJ CITY		SAUDI ARABIA		P		C421		CD-322954		605		NIL		01				
REV. NO. DATE DESCRIPTION		OPRG. DEPT. CTPD ENG. DEPT. AUT-PSAC		RIYADH		SAUDI ARABIA		SAUDI ARABIA		P		C421		CD-322954		605		NIL		01				

THIS DRAWING AND THE INFORMATION CONTAINED HEREIN ARE THE SOLE PROPERTY OF National Grid SA NO REPRODUCTION IN FULL OR IN PART SHALL BE OBTAINED FROM THIS DOCUMENT WITHOUT THE WRITTEN CONSENT OF ITS OWNER.

NG/D2-D (2012/01)

DMS

VECTOR

NGD200